


TOWN OF LEXINGTON — BOARD OF PUBLIC WORKS

SEWER DIVISION

DATE _____

157

Sketch of Service Here

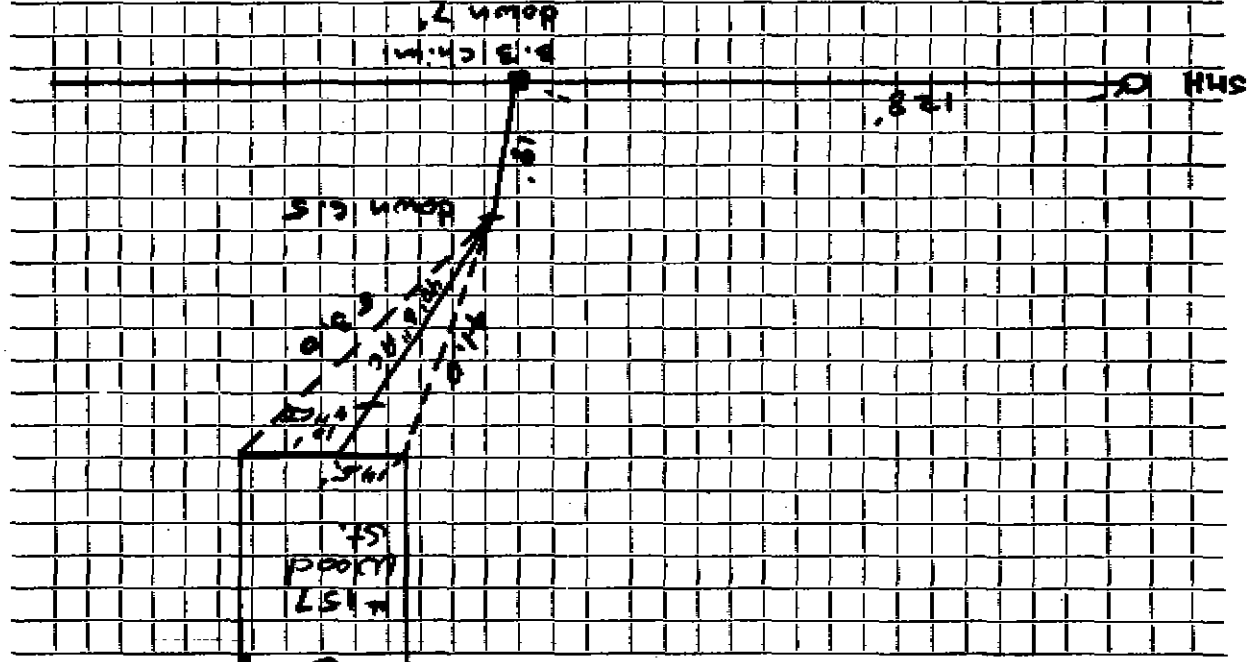

Connection made in Wood St Street. Work completed

Remarks: