




DATE \_\_\_\_\_

# TOWN OF LEXINGTON — BOARD OF PUBLIC WORKS SEWER DIVISION

Sketch of Service Here

164

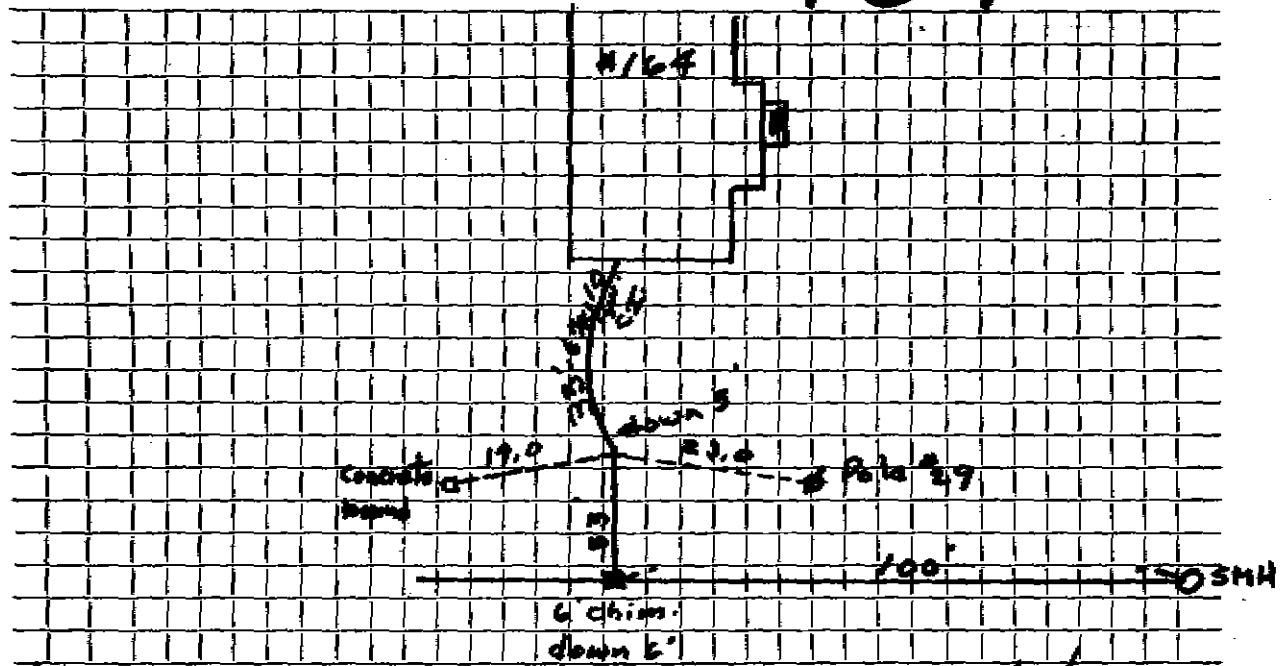

Connection made in <sup>164</sup> Wood St. Street. Work completed 6/2/76

Remarks: Service under stone wall