

Name Earl Outhet

Service No.

Address 165 Wood Street

165 Wood Street

Location

Kind of Pipe

Size 6"

Size of Main 8"

Repair—Renewal—New Service Deflice #974


Location

Date	Material	Amount	Total	Date	Amount
4-29-68	53' 6" Transite pipe				
	10' 4" Cast Iron pipe				

DATE _____

TOWN OF LEXINGTON — BOARD OF PUBLIC WORKS

SEWER DIVISION

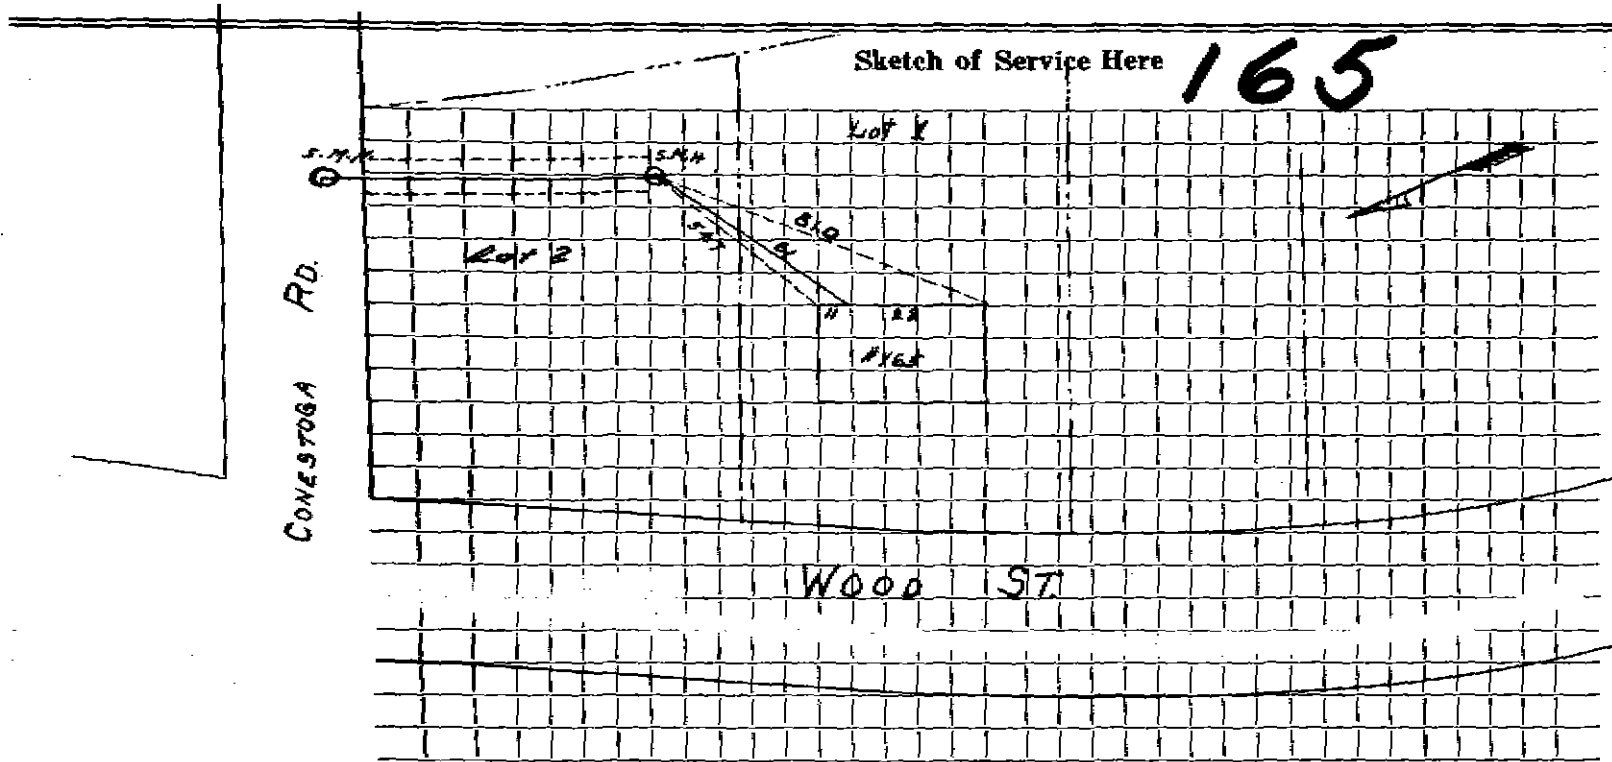

Connection made in Street. Work completed

Remarks: Sewer Rear of House

.....
.....