

Service No.

Address 174 Wood St.

1134 West Street

Locality

Kinds of Pipe A.C.

Size of Main Gas


Size 60

Repair—Recover—Never Service

Date	Material	Amount	Total	Date	Amount
12-8-75	21' - 6" ACP @	\$7.5	\$120.	75	
				9-21-98	Inside installed
					4 - 20" Bands
					7" - 6" PVC
					6x6 PVC to AC fence
					6x4 CT to PVC fence

Remarks:

Connection made in 2000d 5+ Street. Work completed

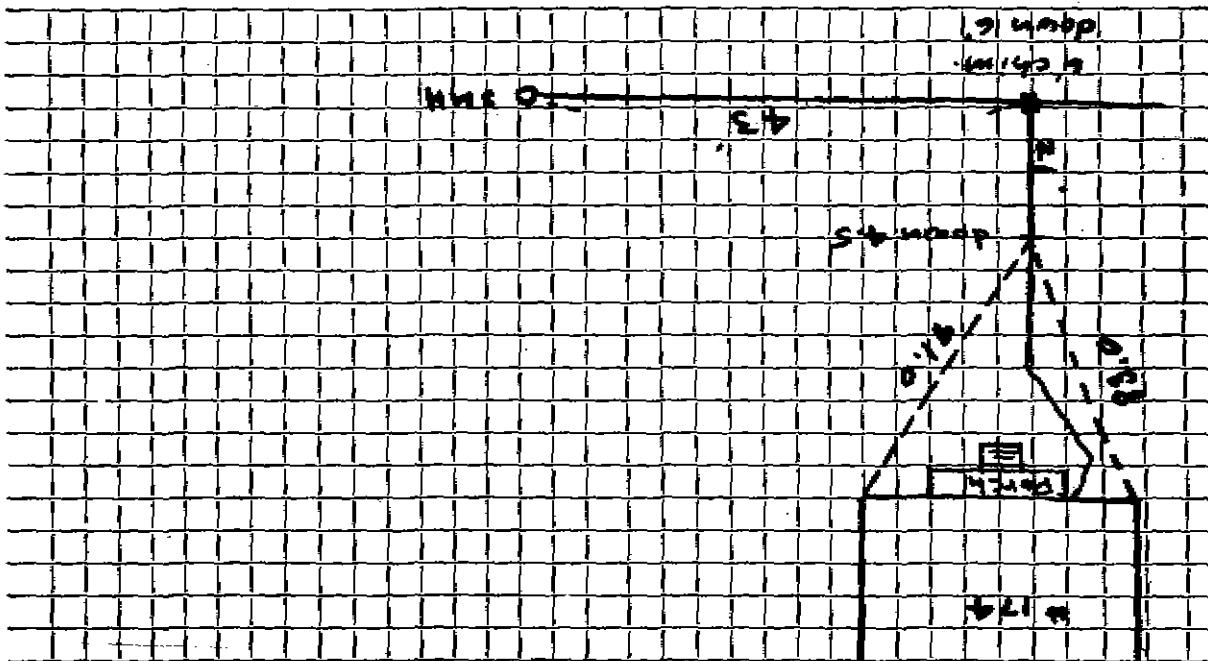

Sketch of Service Here
174

TOWN OF LEXINGTON — BOARD OF PUBLIC WORKS

SEWER DIVISION

DATE