

Name **Norman Cole**

Service No. **28**

Address **180 Wood St.**

180 Wood Street

Location

Kind of Pipe **PVC**

Size **6"**

Size of Main **8"**

~~Repair~~ **New Service D.J. Faulkner #4340**

Location **SEP 5 1986**

Date	Material	Amount	Total	Date	Amount
7/13/83	28 L.F. @ \$16.00	\$448.00		8-25-86	448.00
7/13/83	28 L.F. of 6" PVC	\$16.00	\$448.00		
8/28/86	47'9" 6" PVC				
	6'2" 4" CI				
	1 4" x 6" CI x PVC				


Deposit

DATE _____

TOWN OF LEXINGTON — BOARD OF PUBLIC WORKS

SEWER DIVISION

Sketch of Service Here **180**

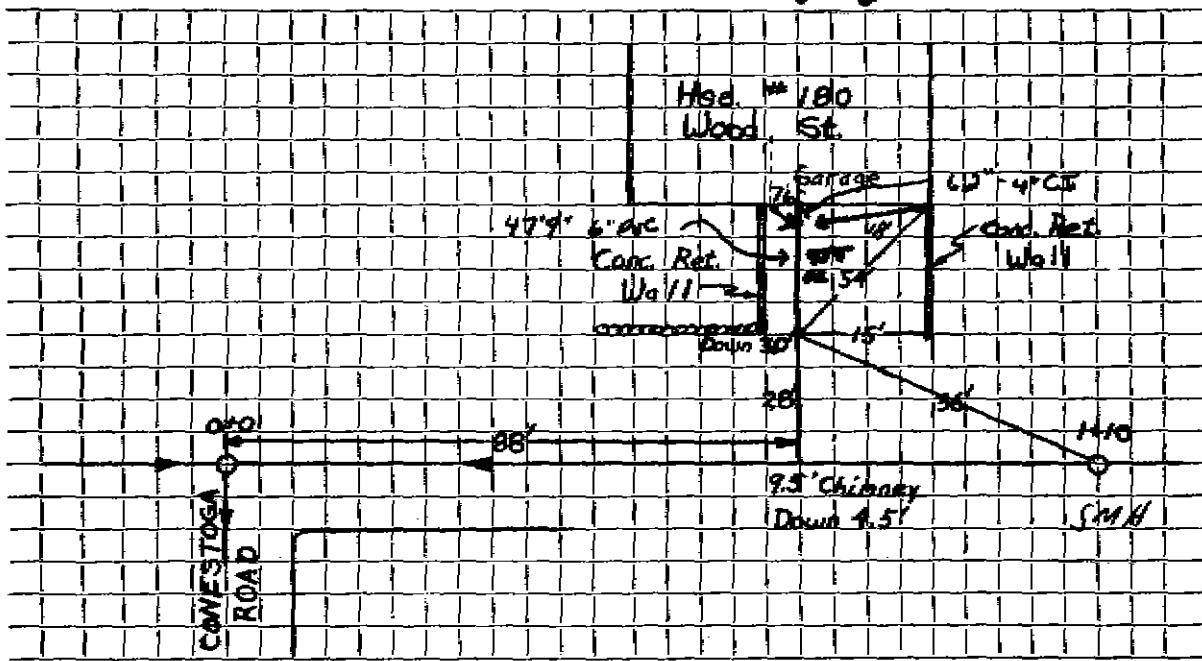

Connection made in Wood Street. Work completed

Remarks:

.....

.....