


DATE 10-23-2001

TOWN OF LEXINGTON — BOARD OF PUBLIC WORKS
SEWER DIVISION

Sketch of Service Here

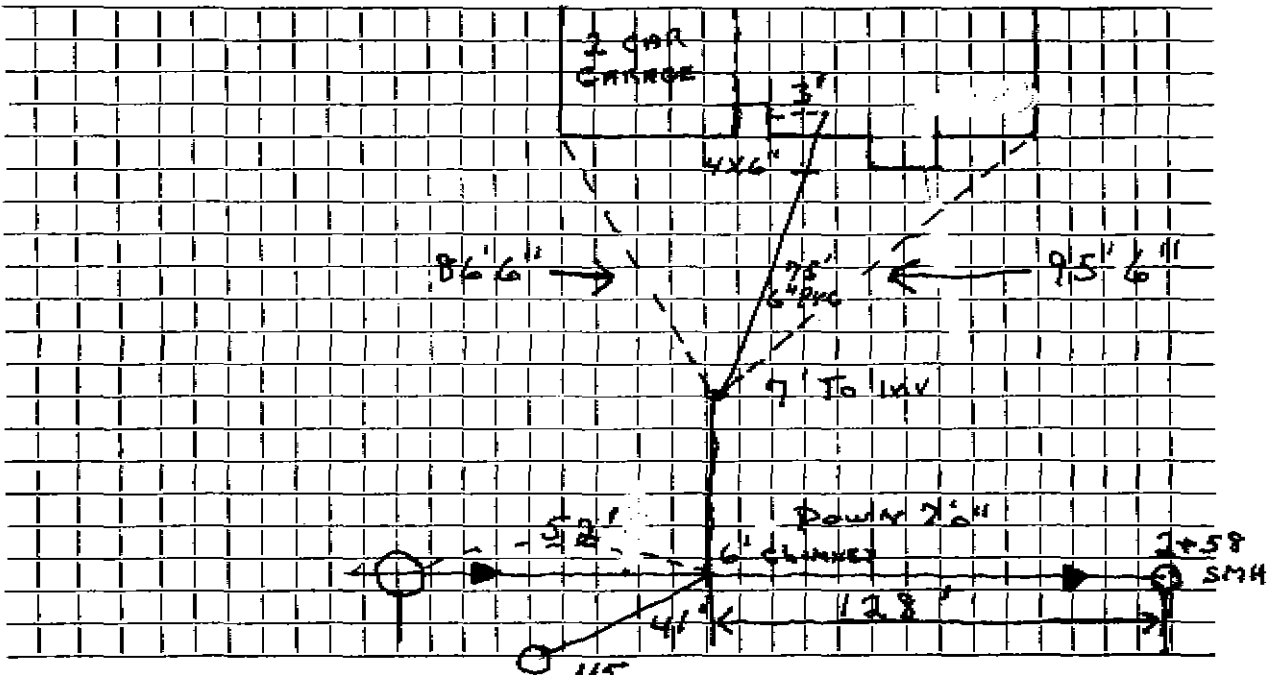

Connection made in .. wood .. Street. $\frac{115}{35}$ Work completed

Remarks: .. INSTALLED BY .. J. McLAUGHLIN ..