


TOWN OF LEXINGTON — BOARD OF PUBLIC WORKS

SEWER DIVISION

DATE

7/30/02

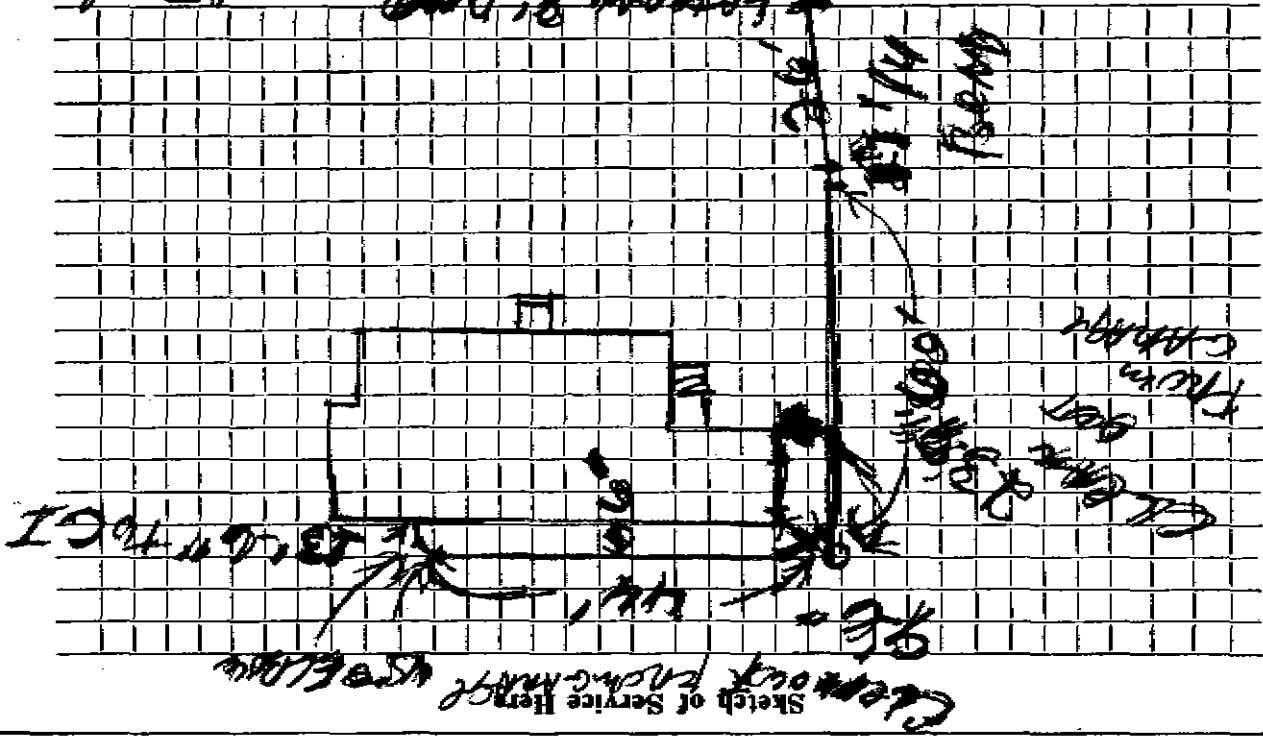

Sketch of Service Here
 Cleanout
 Trap
 Sewer
 Woodst

WOODST

CLEANOUT
 TRAP
 SEWER

WOODST

WOODST
 Street
 Work completed

7/30/02
 Service Macked

Remarks:

Connection made in