


DATE _____

TOWN OF LEXINGTON — BOARD OF PUBLIC WORKS
SEWER DIVISION

Sketch of Service Here

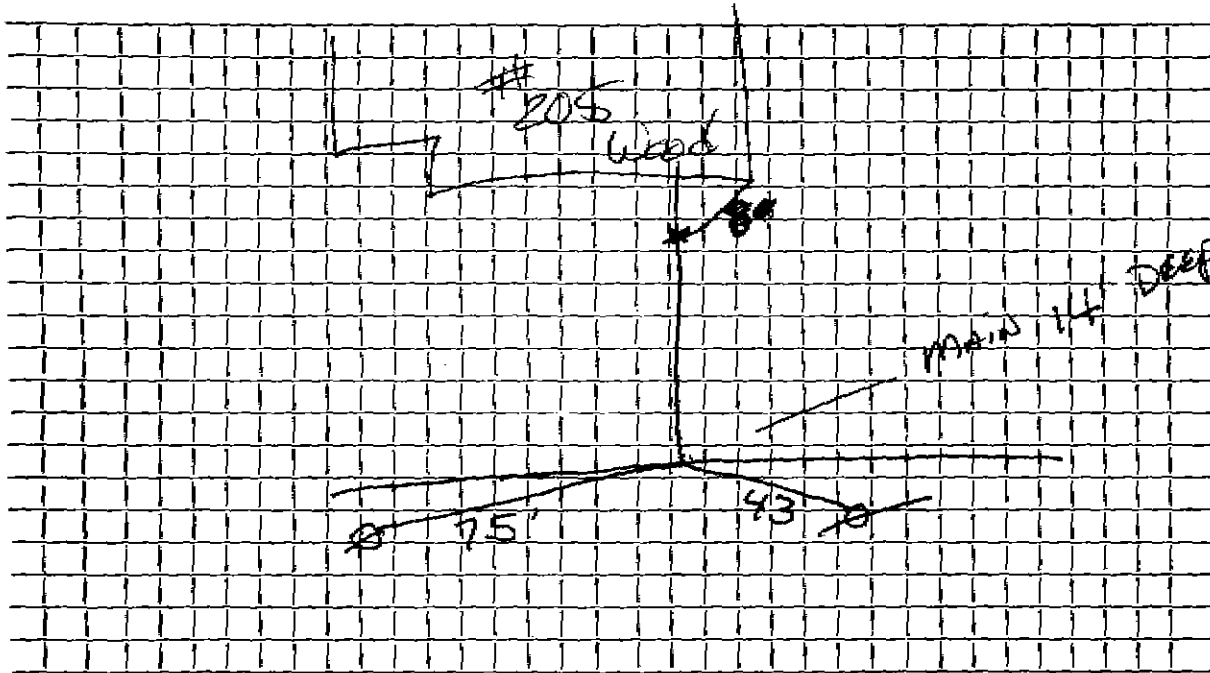

Connection made in Street. Work completed


Remarks:
.....
.....

DATE 7-30-91

TOWN OF LEXINGTON — BOARD OF PUBLIC WORKS
SEWER DIVISION

#205 HOOD ST

Sketch of Service Here **205**

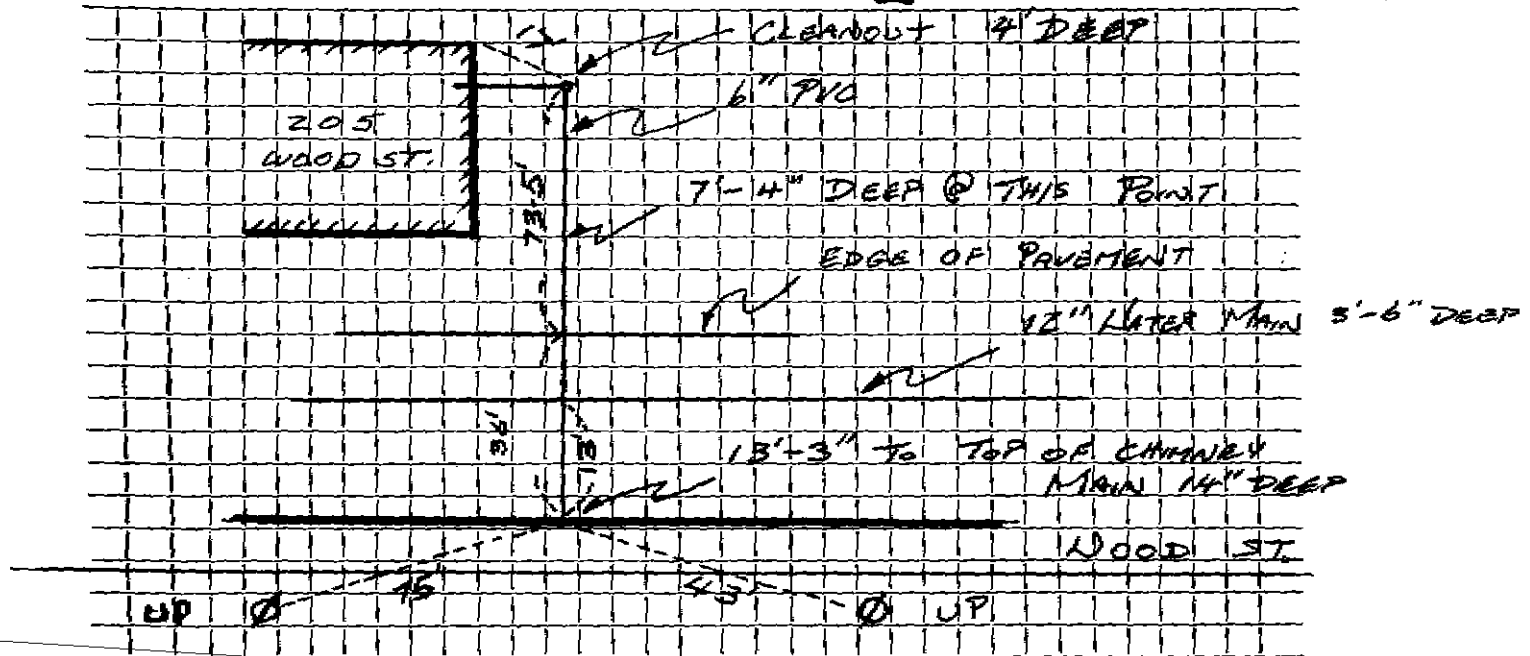

Connection made in HOOD Street. Work completed

Remarks: CONTRACTOR: GATELY & SONS (NOBURN)

INSPECTION: S.P.M. SKELMAN