

Service No.

卷之二

Address 207 Wood Street

207 West Street Location

Kind of Pipe PVC

5

### **Size of Main**

Repair—Renewal—New Service

### **Location**

Total Amount  
Material Rate

7/14/83 26' of C'PVC \$16.00

Remarks:

Connection made in


1100

Street.

Work completed

Street.

7/14/83

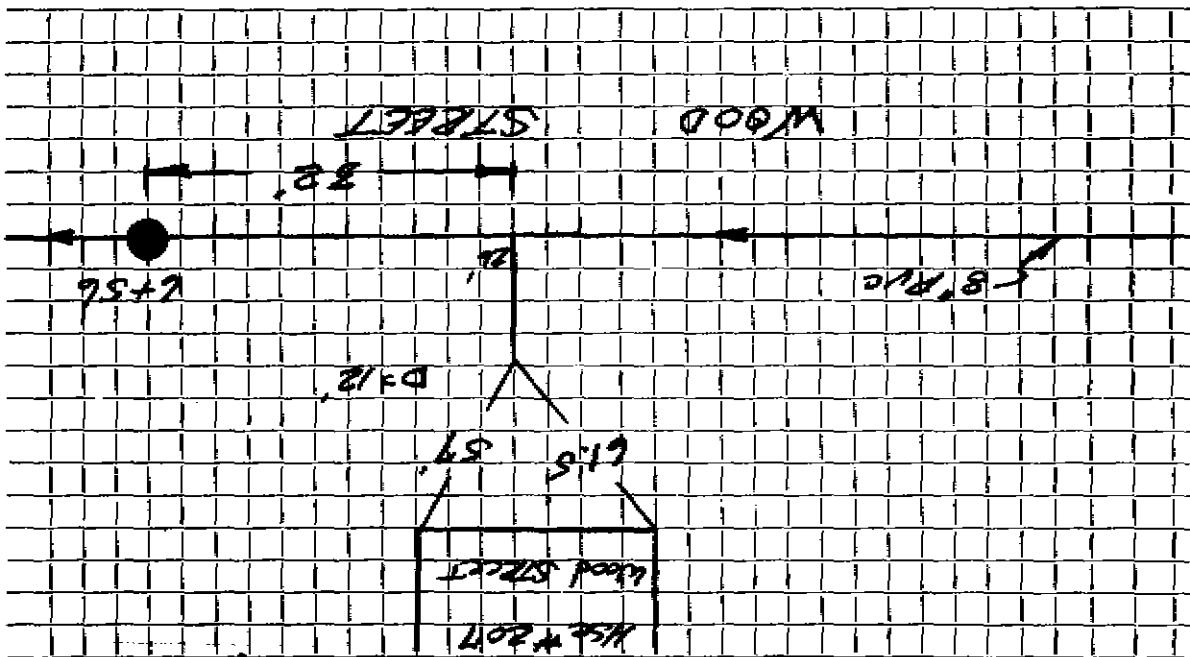

Sketch of Service Here

207

## SEWER DIVISION

TOWN OF LEXINGTON — BOARD OF PUBLIC WORKS

DATE