




DATE 9-91

TOWN OF LEXINGTON — BOARD OF PUBLIC WORKS  
SEWER DIVISION

# 215 HOOD ST.

Sketch of Service Here  
3'-9"

215

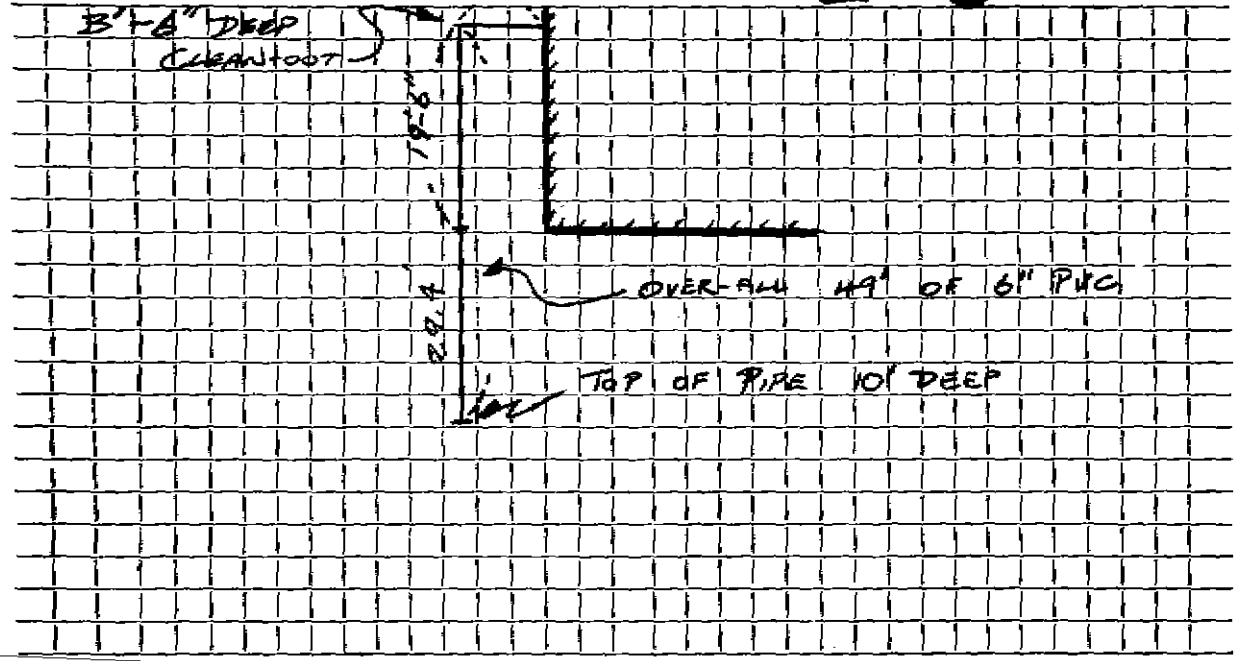

Connection made in # 215 HOOD Street. Work completed .....

Remarks: .....