


DATE _____

TOWN OF LEXINGTON — BOARD OF PUBLIC WORKS
SEWER DIVISION

Sketch of Service Here

221

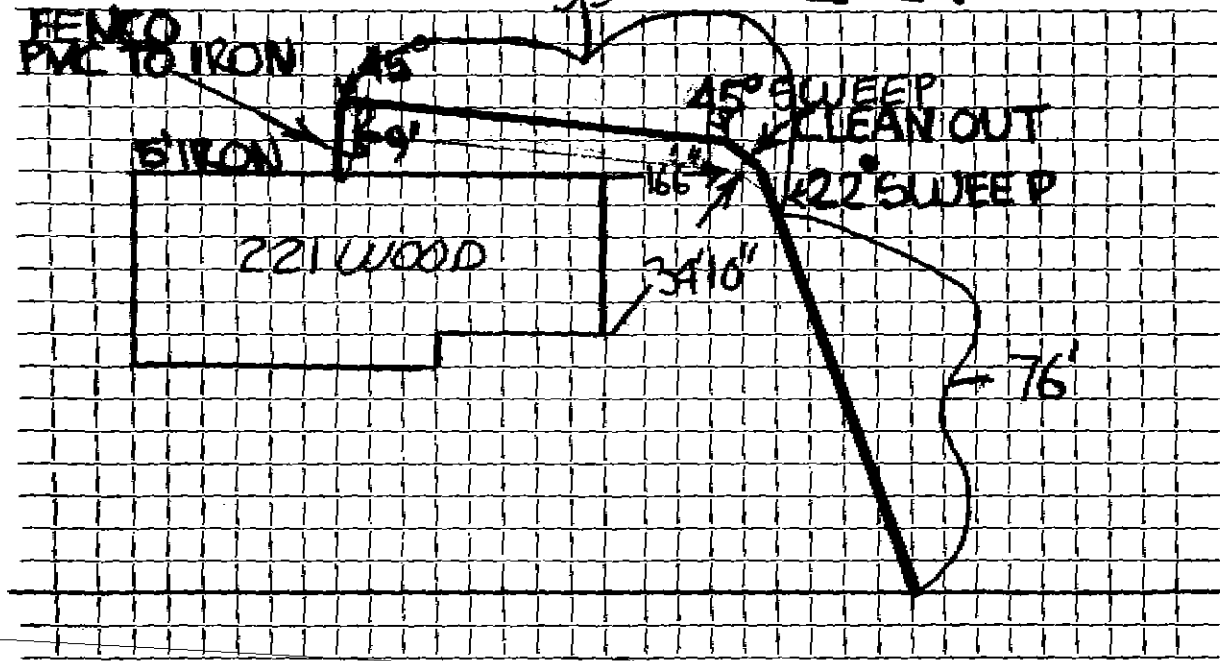

Connection made in Street. Work completed

Remarks: *Down 10' Street*

.....

.....