

Name Pat LaPoente

Service No. 23

Address 227 Wood Street

227 Wood Street

Location

Kind of Pipe AC

Size 6"

Size of Main 8"

~~Revised~~ New Service Valeri #4370

Location

Date	Material	Amount	Total	Date	Amount
7-29 75	22'-6" AC at	✓10.00 =	✓260.00		
5/29/87	53' 6" P.V.C. Pipe				
	5' 4" Iron				
	1 AC to PVC Adpt.				
	1 45° Sweeper				
	4" x 6" Fernco				
	1 6" Coupling				


TOWN OF LEXINGTON — BOARD OF PUBLIC WORKS

SEWER DIVISION

DATE

227

Sketch of Service Here

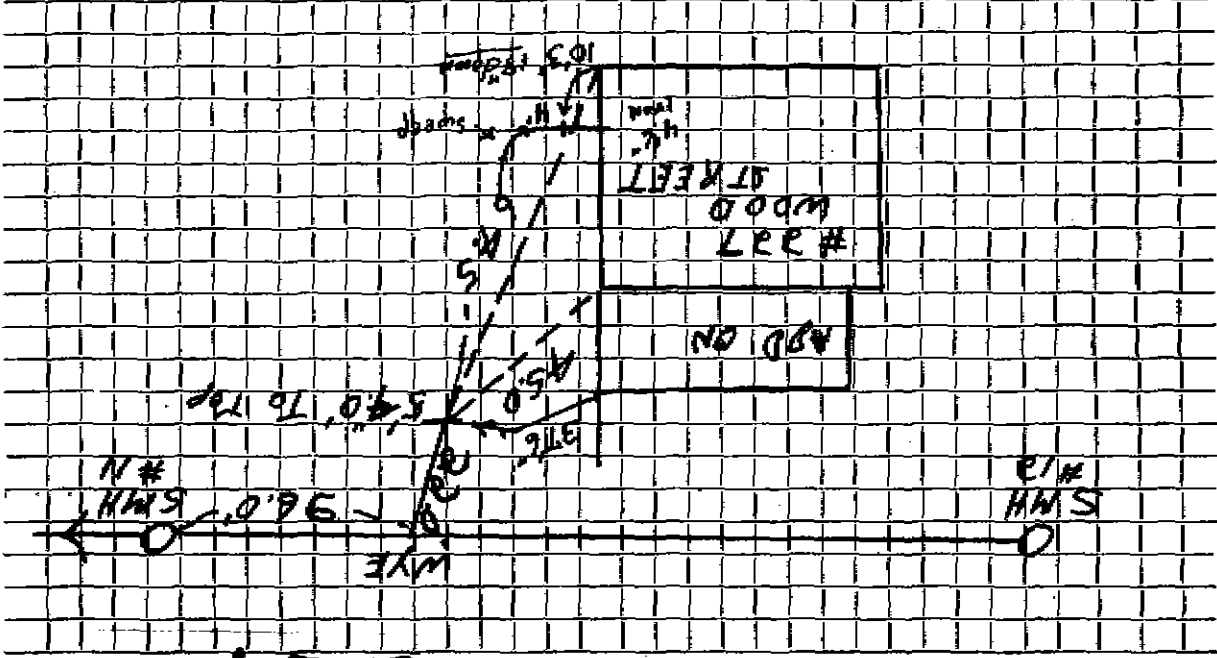

227/10/10

Work completed

Street

Bates Rd

Connection made in

Remarks: