


DATE _____

TOWN OF LEXINGTON — BOARD OF PUBLIC WORKS
SEWER DIVISION

Sketch of Service Here **237**

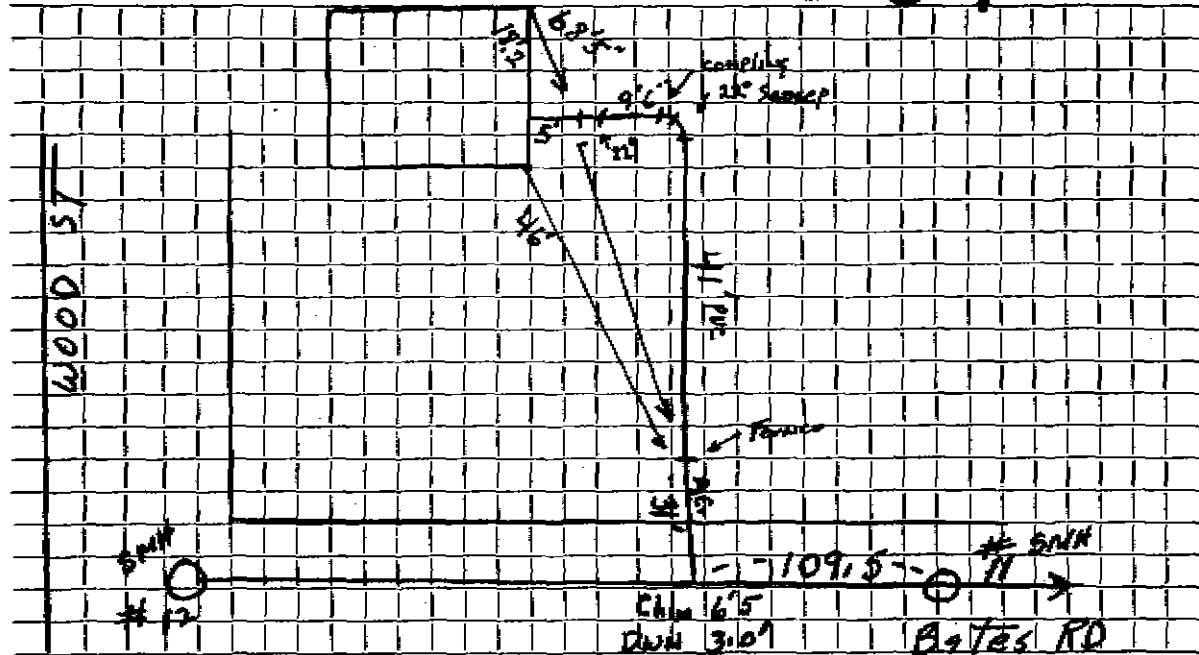

Connection made in Bates R.D. Street. Work completed

Remarks: 1.6" deep iron pipe