

Name

Service No.

Address 249 Wood St

Location

Kind of Pipe PVC Size of Main 8"

Size 6"

Location


Repair—Renewal—New Service *Town Down*

Date	Material	Amount	Total	Date	Amount
7/11/83	11' 6" PVC				
1	3' 0" CHIM.				
April 20 6'	4" Sect. 4-0				
4-4'	6" PVC				
1	4x6 Fence				
1	6" PVC x 6" PVC Fence				
55'	Total 6" PVC				

DATE \_\_\_\_\_

**TOWN OF LEXINGTON — BOARD OF PUBLIC WORKS**  
**SEWER DIVISION**

Sketch of Service Here

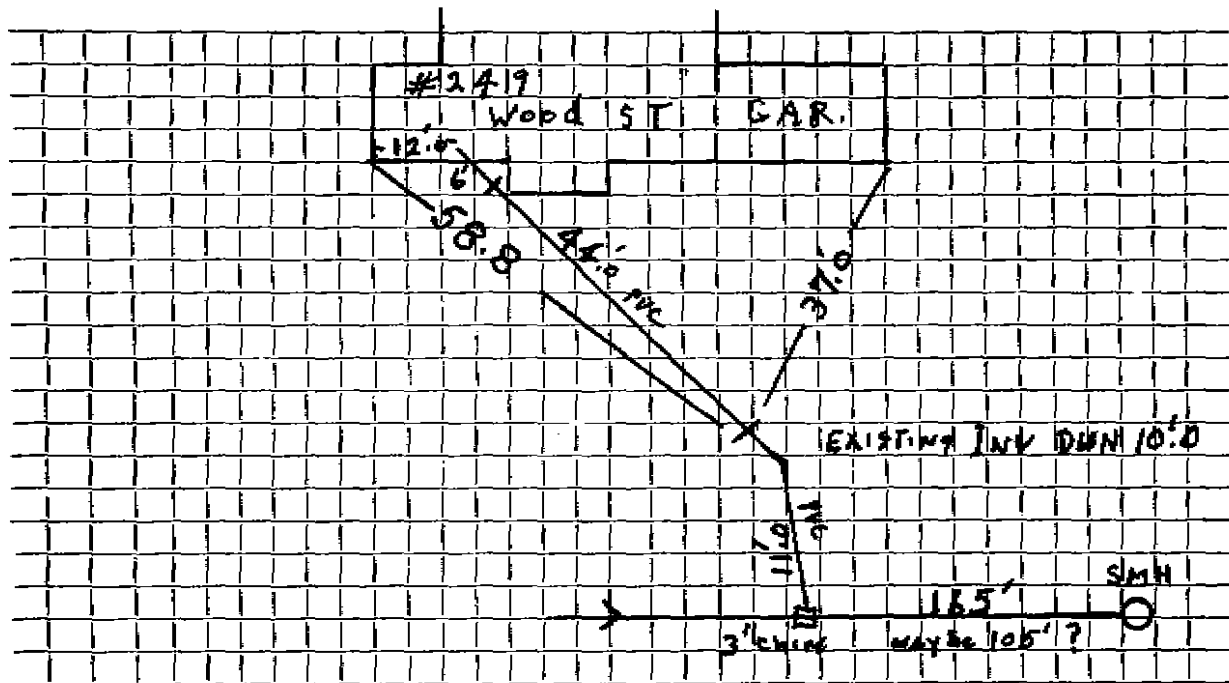

Connection made in ..... Street. Work completed April 2004 .....

Remarks: .....  
.....  
.....