

Name

Service No.

Address 253 Wood St.

253 Wood Street

Location

Kind of Pipe PVC

Size 6"

Size of Main 8"

Repair—Renewal—New Service


Location

Date	Material	Amount	Total	Date	Amount
<del>7/11/03</del>	<del>15 L.F. @ \$16.<sup>00</sup></del>	<del>\$240.<sup>00</sup></del>			
7/11/03	15 L.F. of 6" PVC	\$16. <sup>00</sup>	\$240. <sup>00</sup>	pd (4)	9/13/10
2010 4"	326 40				
19'	6" PVC				
1	6" Clean out				
{ 1	6x6 Fernco PVC & PVC				
{ 1	11/2 bend				

TOWN OF LEXINGTON — BOARD OF PUBLIC WORKS  
SEWER DIVISION

Sketch of Service Here

**253**

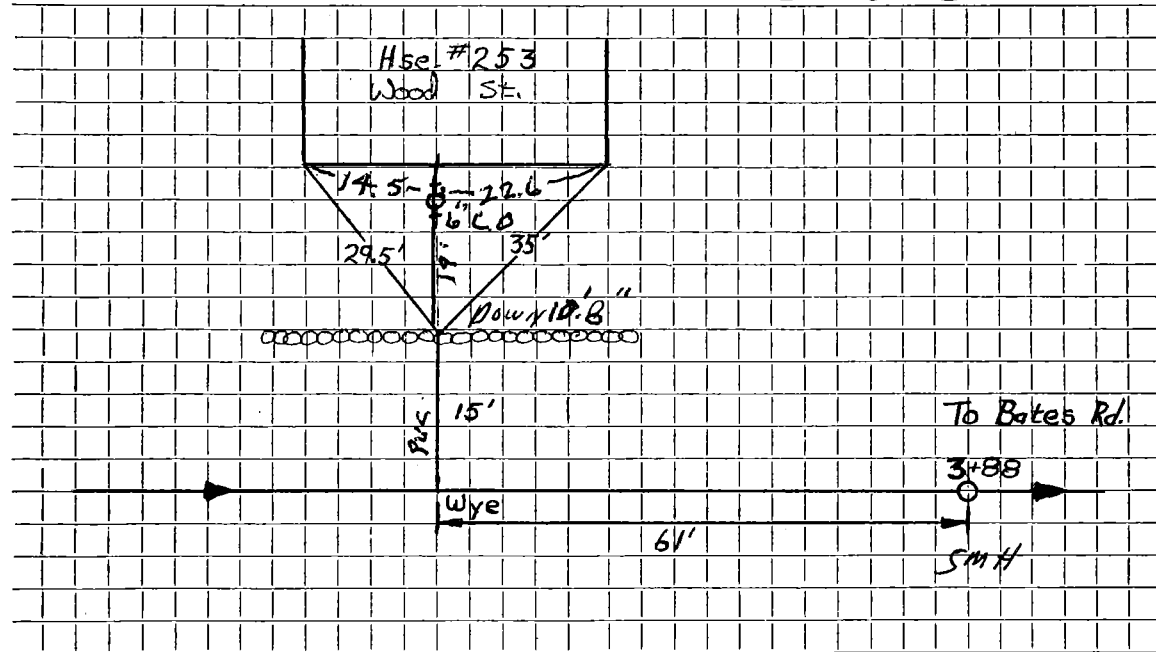

Connection made in ... Wood ... Street. Work completed .....

Remarks: .....  
.....  
.....