


DATE July 1, 1983

TOWN OF LEXINGTON — BOARD OF PUBLIC WORKS
SEWER DIVISION

Sketch of Service Here

259

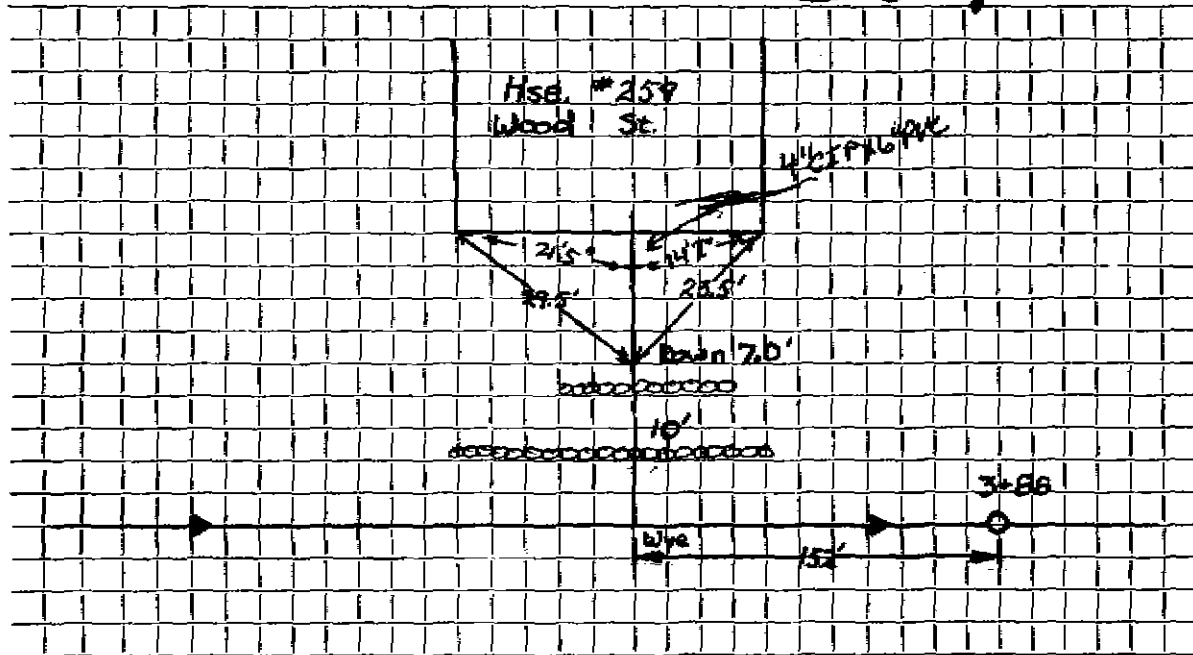

Connection made in Wood Street. Work completed SEPT. 14, 1983

Remarks: