




DATE July 1983

TOWN OF LEXINGTON — BOARD OF PUBLIC WORKS

SEWER DIVISION

263

Sketch of Service Here

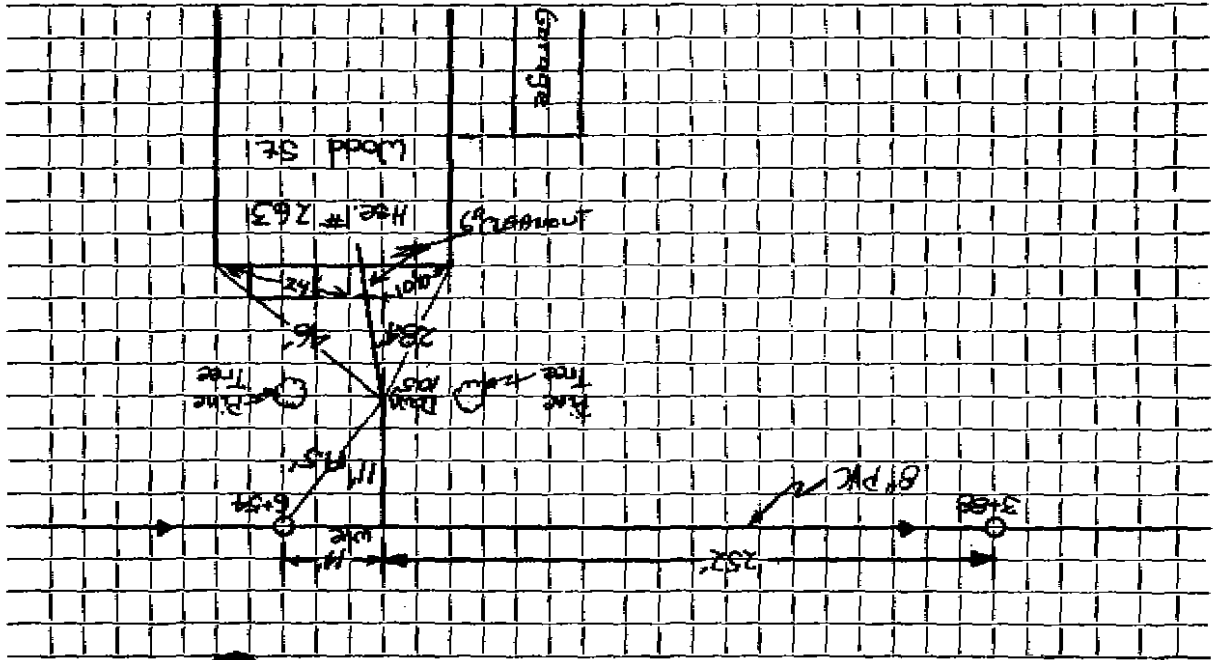

Connection made in Lodd Street Work completed SEPT 21, 1983

Remarks: