

Name

Service No.

Address 269 Wood Street

269 Wood Street

Location

Kind of Pipe PVC

Size 6"

Size of Main 8"

Repair—Renewal—New Service

Location

Date	Material	Amount	Total	Date	Amount
7/11/83	16' of 6" PVC	76.00	256.00		
6-24-89	Inside installed				
	78' 6" PVC				
	1- 6x6 PVC to PVC frame				
	1- 6x6x4 wye cleanout				


DATE _____

TOWN OF LEXINGTON — BOARD OF PUBLIC WORKS

SEWER DIVISION

Sketch of Service Here

269

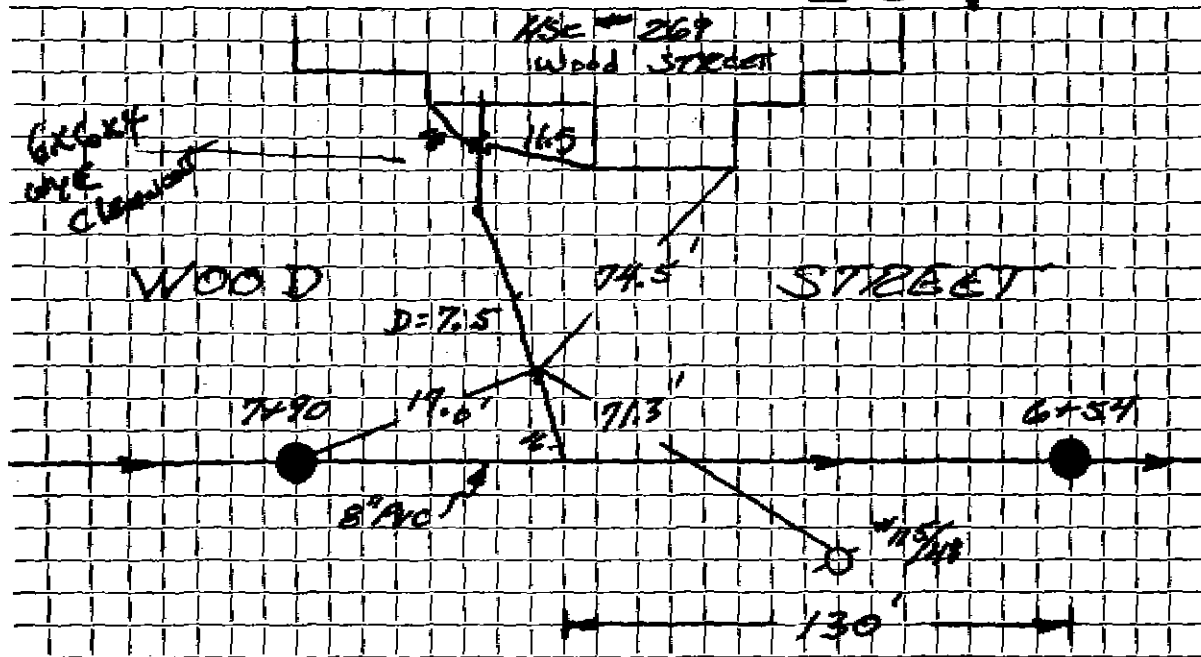

Connection made in WOOD Street. Work completed 7/11/83

Remarks: _____

