




DATE \_\_\_\_\_

TOWN OF LEXINGTON — BOARD OF PUBLIC WORKS  
SEWER DIVISION

Sketch of Service Here **275**

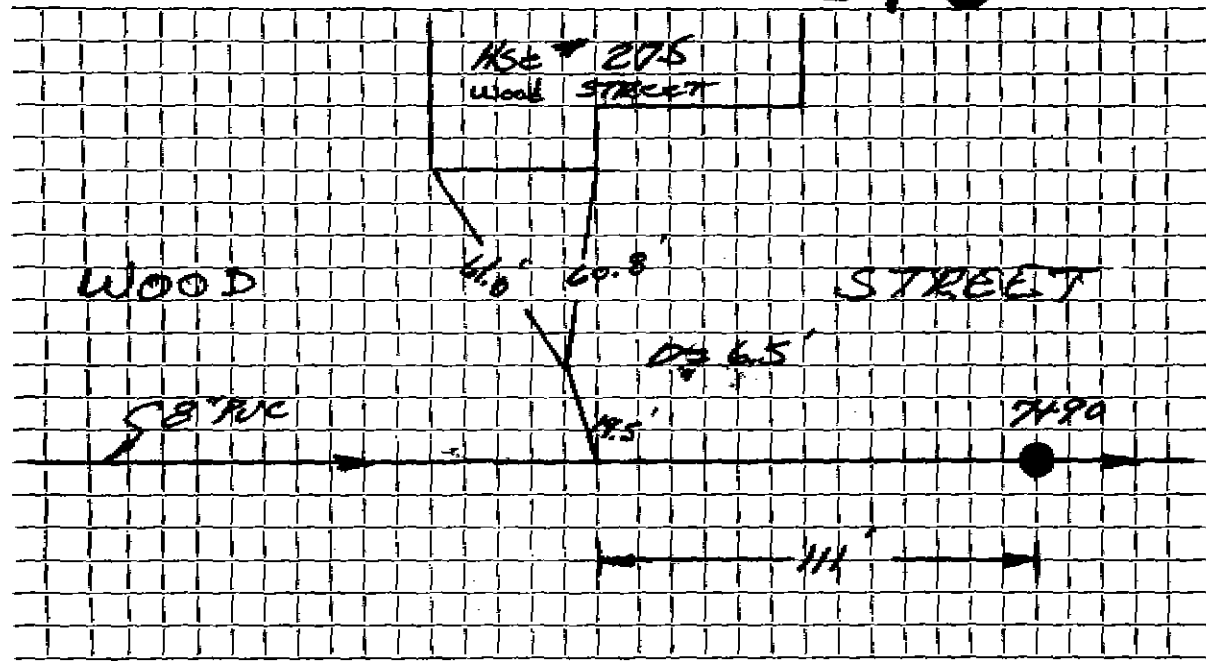

Connection made in Wood Street. Work completed 7/11/83


Remarks: \_\_\_\_\_  
\_\_\_\_\_  
\_\_\_\_\_



DATE JAN 15 1978

TOWN OF LEXINGTON — BOARD OF PUBLIC WORKS  
SEWER DIVISION

Sketch of Service Here

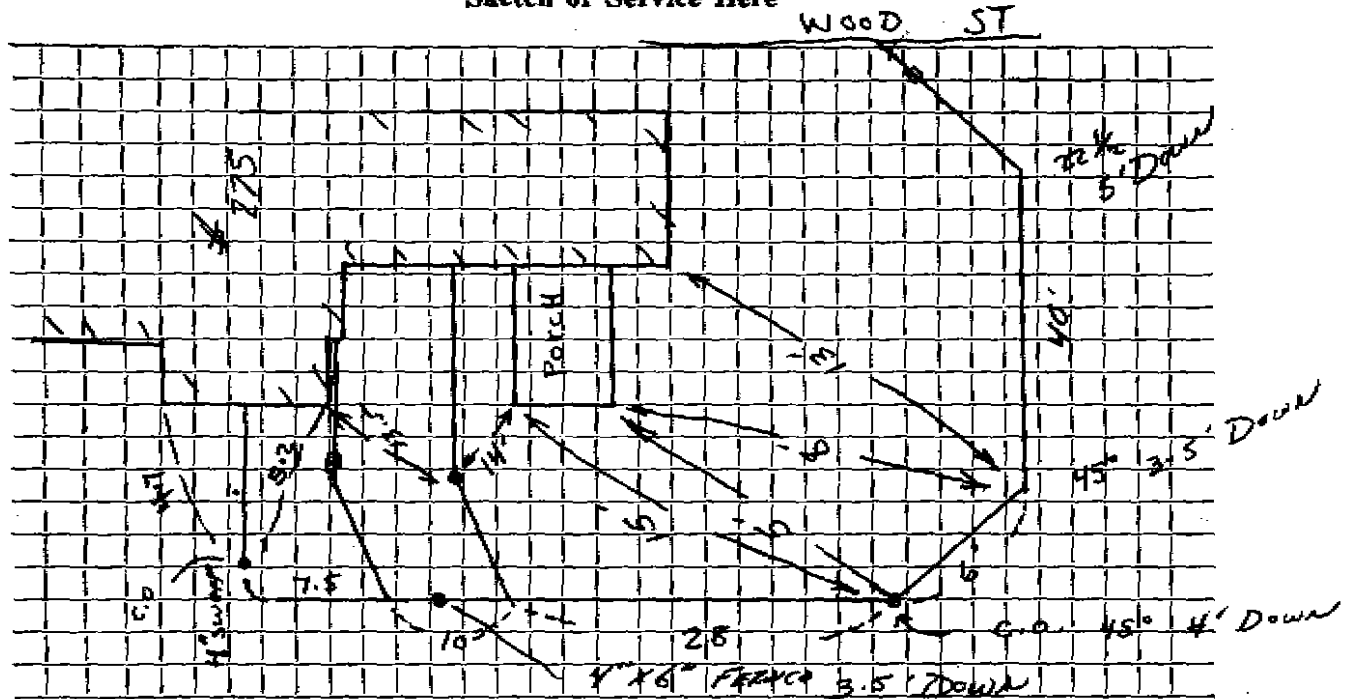

Connection made in WOOD ST Street. Work completed SEWERMAN

Remarks: .....

..... FIELD BOOK 97-5 ..... TJM .....