




DATE August 11, 1983

TOWN OF LEXINGTON — BOARD OF PUBLIC WORKS  
SEWER DIVISION

Sketch of Service Here **277**

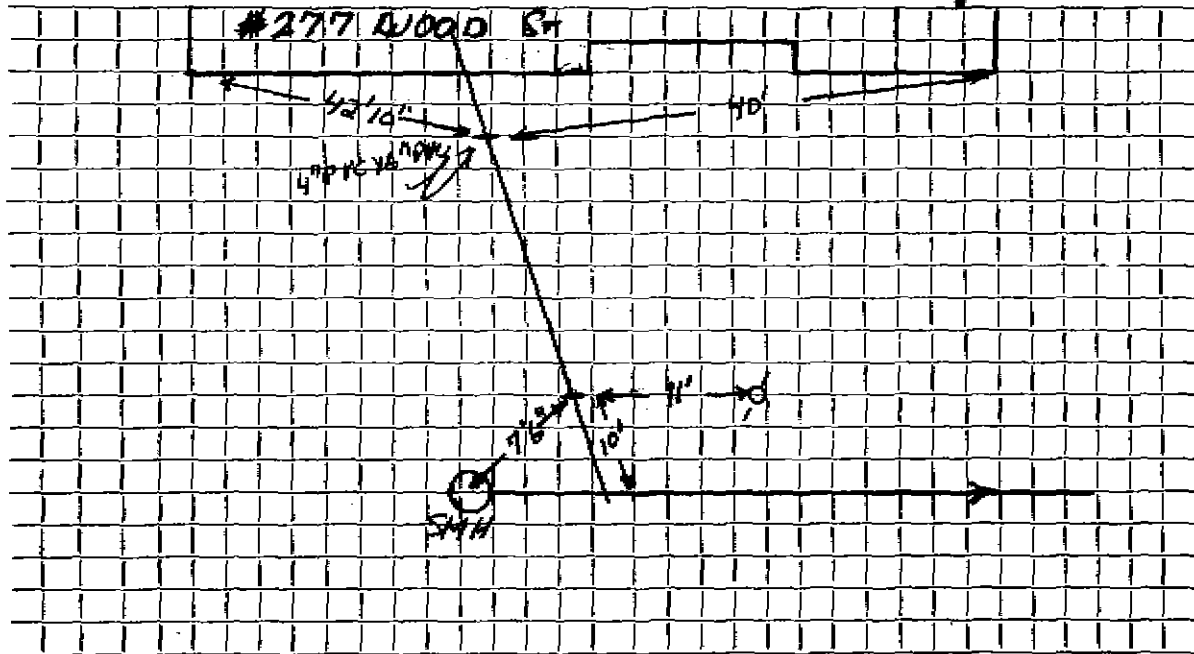

Connection made in WOOD ST. Street. Work completed NOVEMBER 14, 1984

Remarks: .....

.....

.....