

Name M. Murray Roberts

Service No. 41

Address 28 Wood Street

28 Wood Street

Location

Kind of Pipe

Size 6"

Size of Main 8"

~~Repair Renewal~~ New Service

Location


Comm 6-1961

Date	Material	Amount	Total	Date	Amount	
5-5-61	Labor	46.70		5-1-61	Deposit	250.00
5-8-61	"	70.36	117.06	6-18-61	Retard	5.46
	10% O.H.	11.71	128.77			244.54
64'	6" Transite pipe @.78		49.92			
1	22 $\frac{1}{2}$ " Transite Bend		6.21			
1	22 $\frac{1}{2}$ " Transite Elbow		2.24			
1	90° Transite Elbow		5.40			
2	hrs. Town Shovel @6.50		13.00			
2	hrs. Pippin Shovel @5.00		10.00			
3	hrs. Trucking @3.00		9.00			
20	x 3 Patch		20.00			
			244.54			

DATE _____

TOWN OF LEXINGTON — BOARD OF PUBLIC WORKS
SEWER DIVISION

Sketch of Service Here **28**

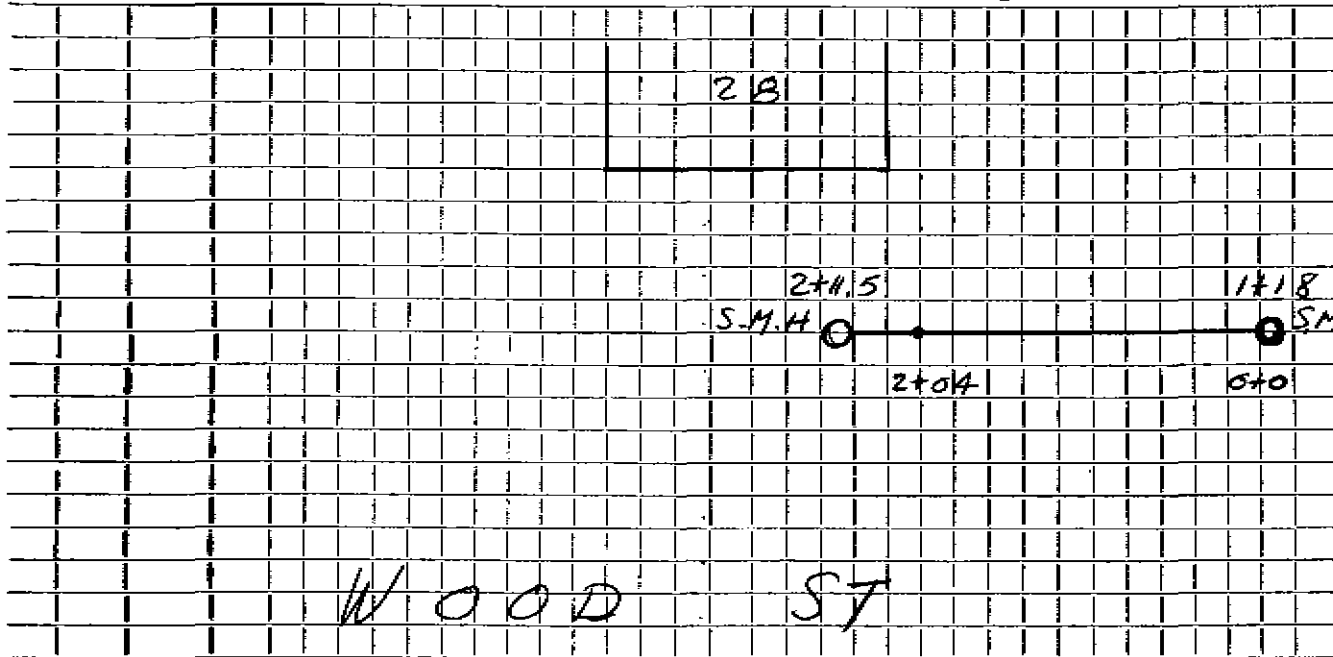

4.5 CHIMNEY
9' COVER.

Connection made in Street. Work completed

Remarks:
.....
.....