


DATE _____

TOWN OF LEXINGTON — BOARD OF PUBLIC WORKS
SEWER DIVISION

Sketch of Service Here **289**

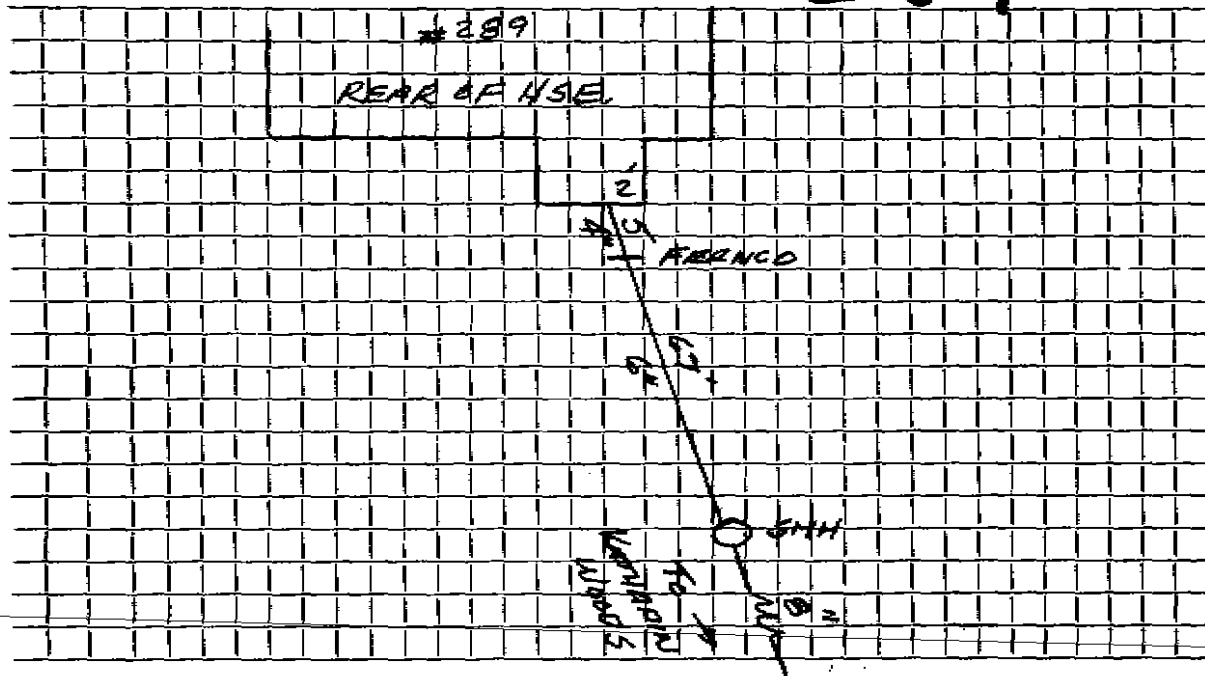

Connection made in SMH Street. Work completed

Remarks: SERVICED OUT REAR TO EXISTING SMH ON KATHADIN WOODS EASEMENT.

