

Service No.

Cosgrove

Address 291 Wood St.

291 Wood Street

Location

Kind of Pipe PVC

Size 4" x 6"

Size of Main 8"

Repair—Renewal—New Service

Location


Faulkner 14530

Date	Material	Amount	Total	Date	Amount
11/23/87	55 LF 6" PVC				
	5 LF 4" PVC				
	4" x 6" FERRO				

DATE _____

TOWN OF LEXINGTON — BOARD OF PUBLIC WORKS
SEWER DIVISION

Sketch of Service Here **291**

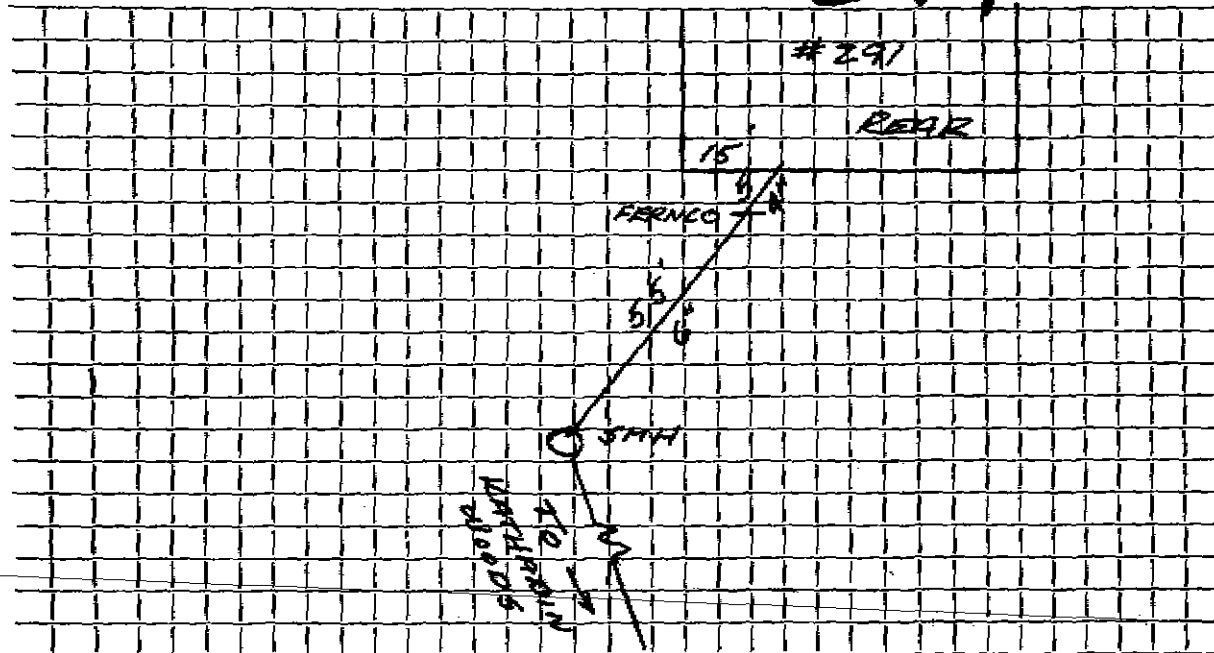

Connection made in EXIST. SMH..... Street. Work completed

Remarks: SERVICE OUT REAR TO EXIST. SMH ON KATHADIN WOODS EASEMENT.....