

Name Mildred M. Armstrong

Service No. 13

Address 34 Wood Street

34 Wood Street

Location

Kind of Pipe

Size 6"

Size of Main 8"

~~Repaired~~ New Service

W.O. #7817

Location

Comm 5-27-63


Date	Material	Amount	Total	Date	Amount
4-15-63	Labor	50.45		4-4-63	400.00
4-16-63	"	61.23	111.68	5-27-63	44.95
	10% O.H.	11.17	122.85		355.07
79'	6" Transite pipe @.82		187.63		
1	90° Transite Elbow		4.09		
3	hrs. Town Shovel @6.50		19.50		
3	hrs. Trucking @3.00		9.00		
12	x 3 Patch		12.00		
			355.07		

DATE \_\_\_\_\_

# TOWN OF LEXINGTON — BOARD OF PUBLIC WORKS

## SEWER DIVISION

Sketch of Service Here **34**

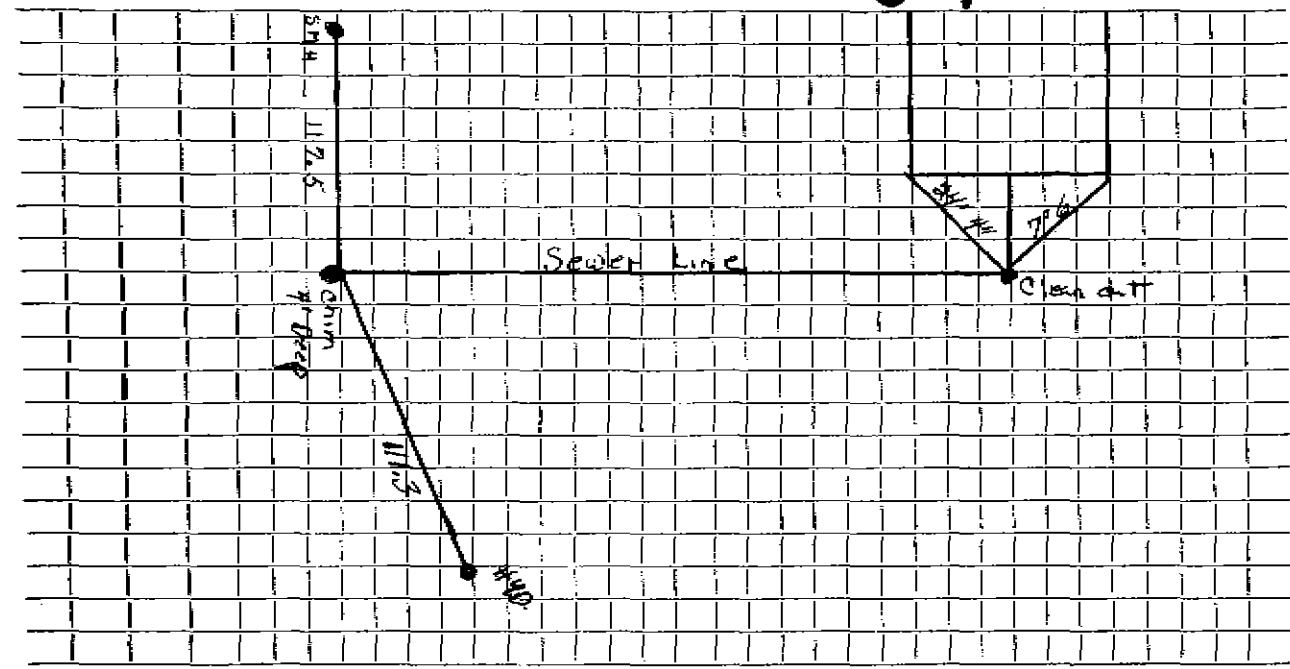

Connection made in ..... Street. Work completed .....

Remarks: .....  
.....  
.....