




DATE \_\_\_\_\_

**TOWN OF LEXINGTON — BOARD OF PUBLIC WORKS**  
**SEWER DIVISION**

Sketch of Service Here

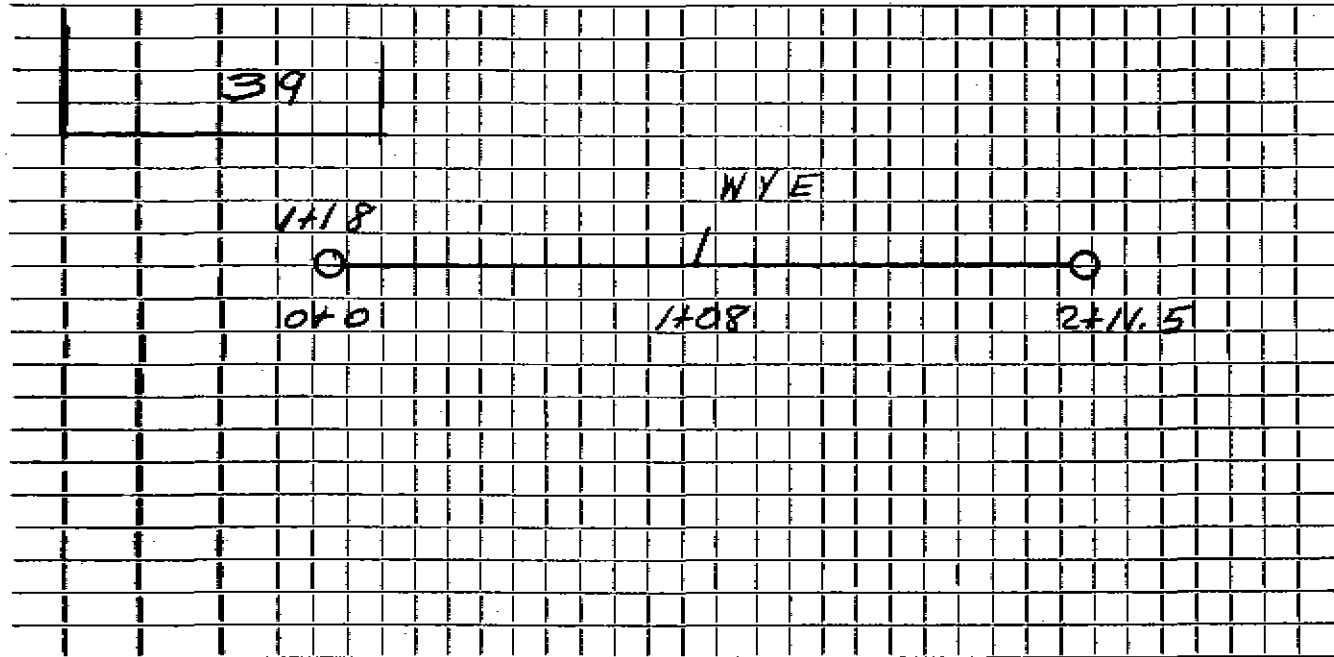

7.5' DOWN

Connection made in ..... Street. Work completed .....

Remarks: .....  
.....  
.....