

Name Thomas H. MacLeod

Service No. 234

Address 40 Wood Street

40 Wood Street

Location

Kind of Pipe

Size 6"

Size of Main 8"

REPAIRS - New Service

Locations

Case 12-2-10

Date	Material	Amount	Total	Date	Amount
11-5-60	Labor	66 73		11-11-60	
	10% O.H.	6 67	73 40	11-12-60	
62' 6"	Transite pipe		48 35		
4	Sticks Dynamite		1 04		
3	Blasting Caps		84		
1	6" 90° Transite Elbow		5 40		
1	22 1/2° Transite Bends		6 27		
2	11 1/4° Transite Bends		10 20		
5	Hrs. Pippin Shovel @4.50		22 50		
2	Hrs. Trucking @3.00		6 00		
1	Hr. Compressor @4.00		3 00		
			176 95		


Deposit
 Refund
 271 88
 176 95
 176 95

DATE _____

TOWN OF LEXINGTON — BOARD OF PUBLIC WORKS
SEWER DIVISION

Sketch of Service Here

40

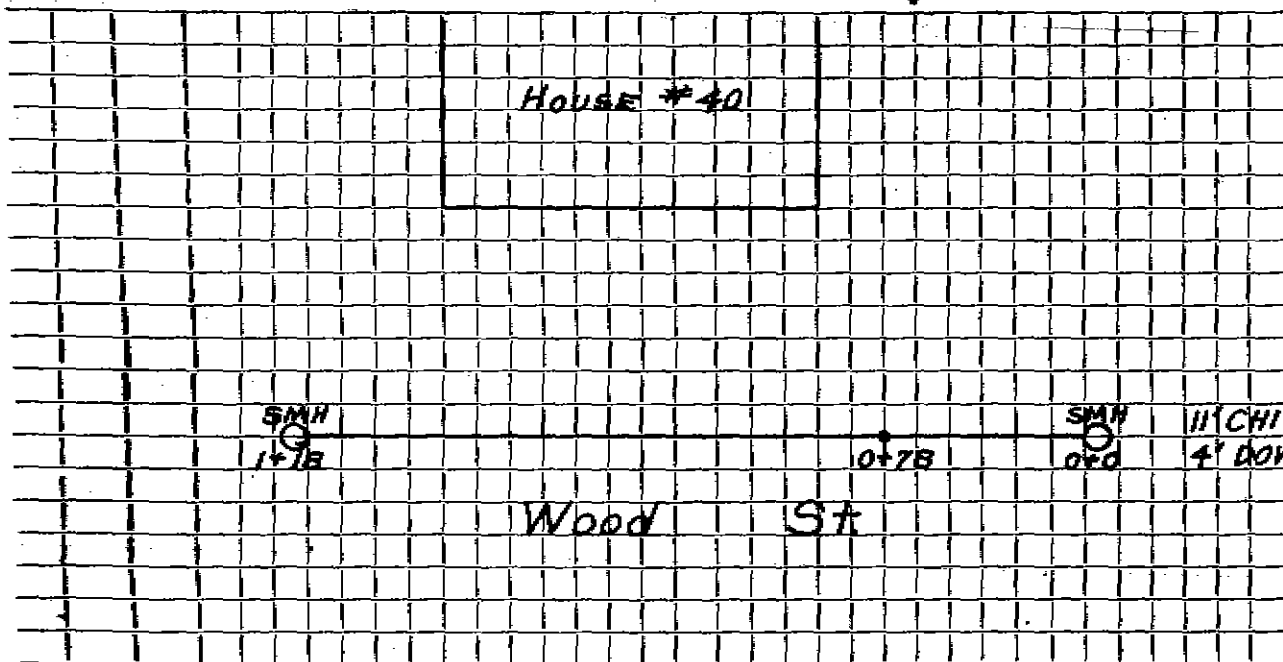

Connection made in Street. Work completed

Remarks:

.....

.....