

Name Don Worthington

Service No. 67

Address 43 Wood Street

43 Wood Street

Location

Kind of Pipe Transite Pipe

Size 6"

Size of Main 8"

New Service W.O. #3523. Lexington Sewerage Permit #2695.

Location

NOV 24 1976

Date	Material	Amount	Total	Date	Amount
7-24-75	Labor	129.16		2-14-76	350.00
	10 % D.H.	12.92	\$142.08	11-14-76	<del>94.93</del>
10	6" Transite Pipe	@1.48	14.80		355.08
5'	6" Transite Pipe	@1.56	7.80		
1	24" x 6" Nipple		5.39		
1	22½" Bend		9.26		
1	Ton Cold Patch		13.25		
1	Hr. Trucking		3.00		
1	Hr. Pickup		1.50		
1	Hr. Loader		4.00		
4	Hrs. Backhoe	@6.50	26.00		
1	Patch 4' x 10'		28.00		
			\$255.08		


TOWN OF LEXINGTON — BOARD OF PUBLIC WORKS

SEWER DIVISION

DATE \_\_\_\_\_

43

Sketch of Service Here

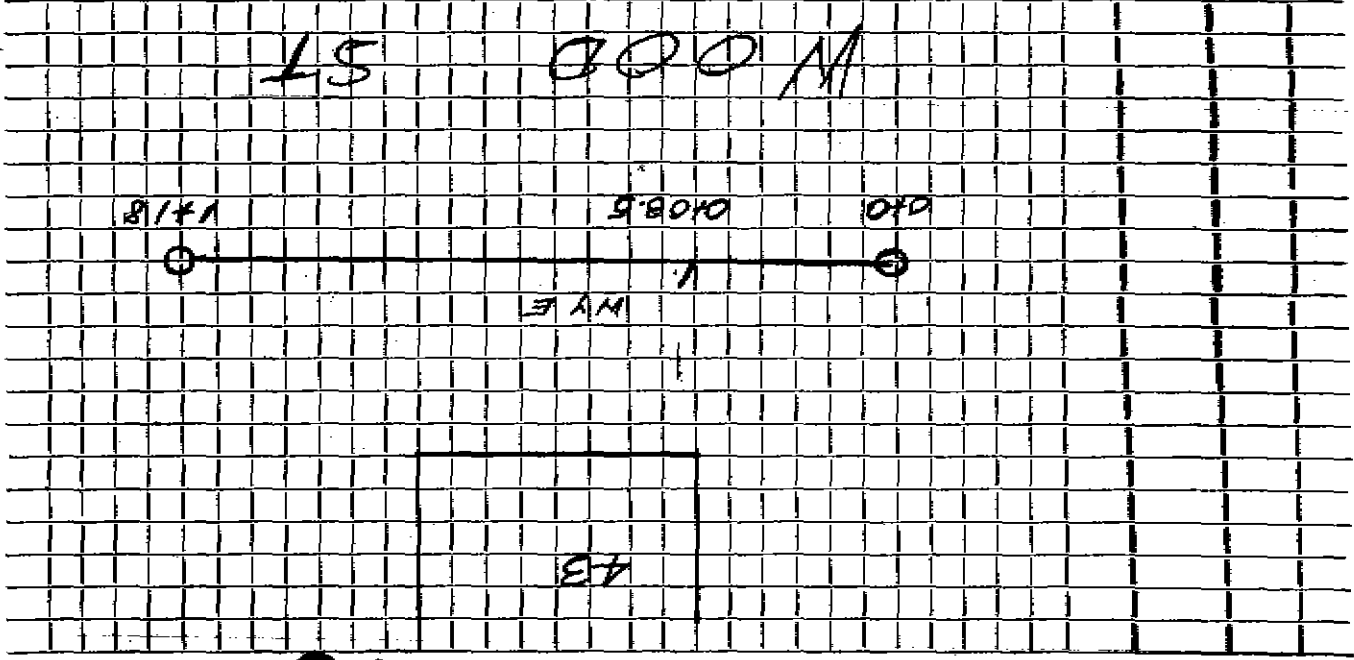

Connection made in \_\_\_\_\_ Street. Work completed \_\_\_\_\_

Remarks: \_\_\_\_\_