


DATE _____

TOWN OF LEXINGTON — BOARD OF PUBLIC WORKS
SEWER DIVISION

Sketch of Service Here

47 WOOD ST.

47

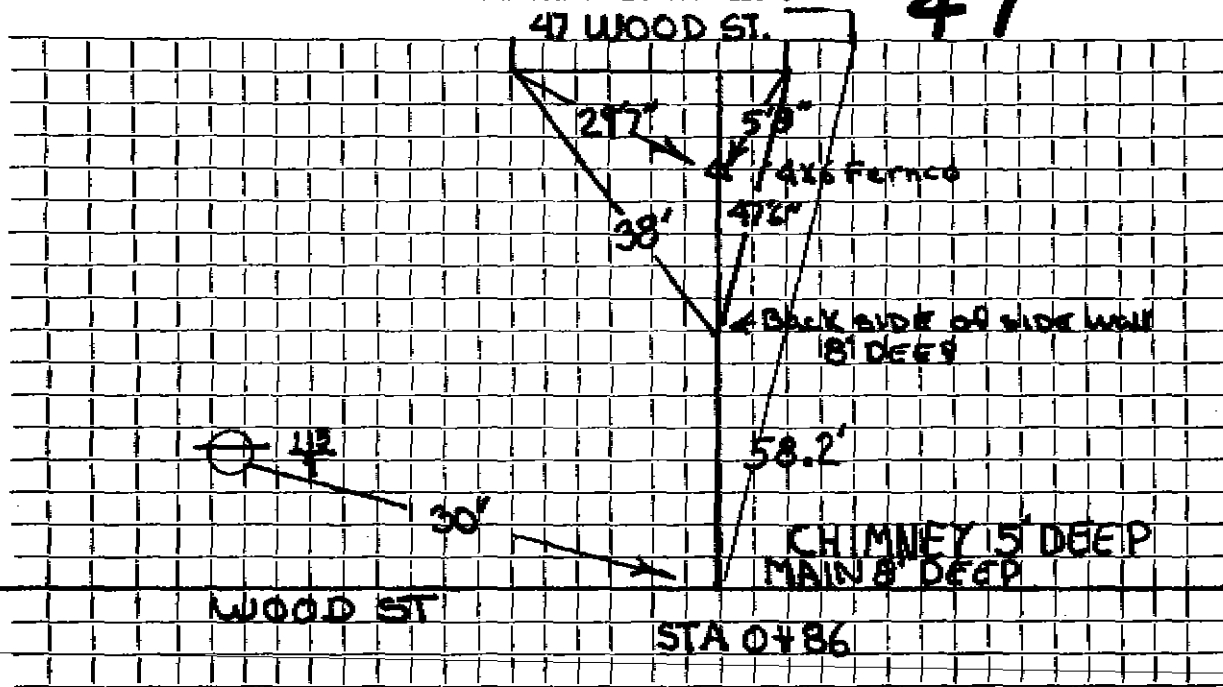

SMH
○
STA 0+00

SMH
○
STA 1+34
8" STUB

Connection made in Street. Work completed

Remarks: