


DATE

TOWN OF LEXINGTON — BOARD OF PUBLIC WORKS
SEWER DIVISION

54

Sketch of Service Here

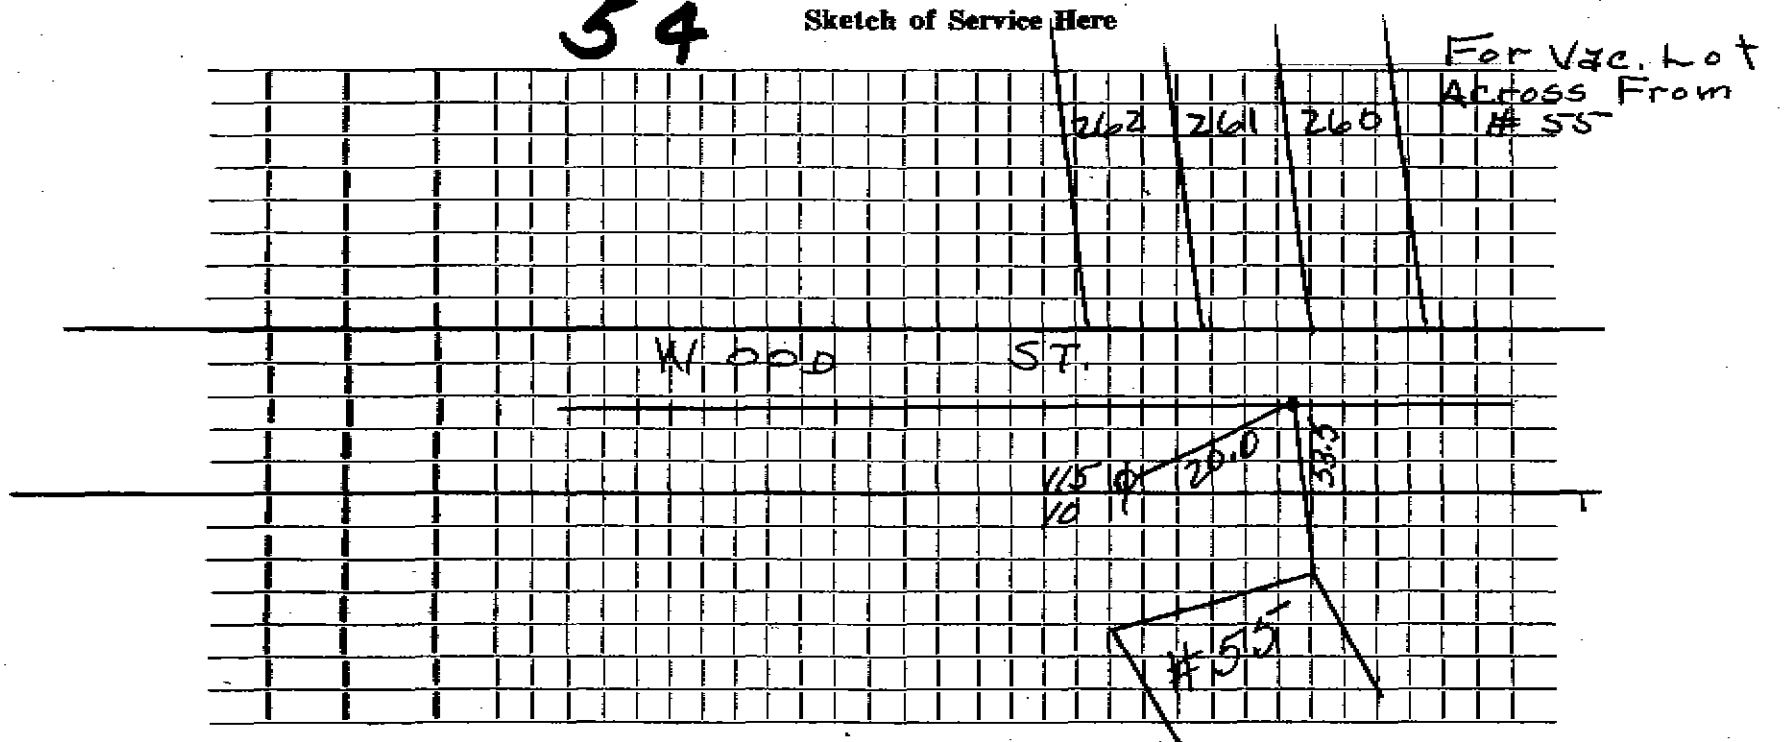

Connection made in Street. Work completed

Remarks:

.....

.....