


TOWN OF LEXINGTON — BOARD OF PUBLIC WORKS
SEWER DIVISION

DATE 4/2021

Sketch of Service Here

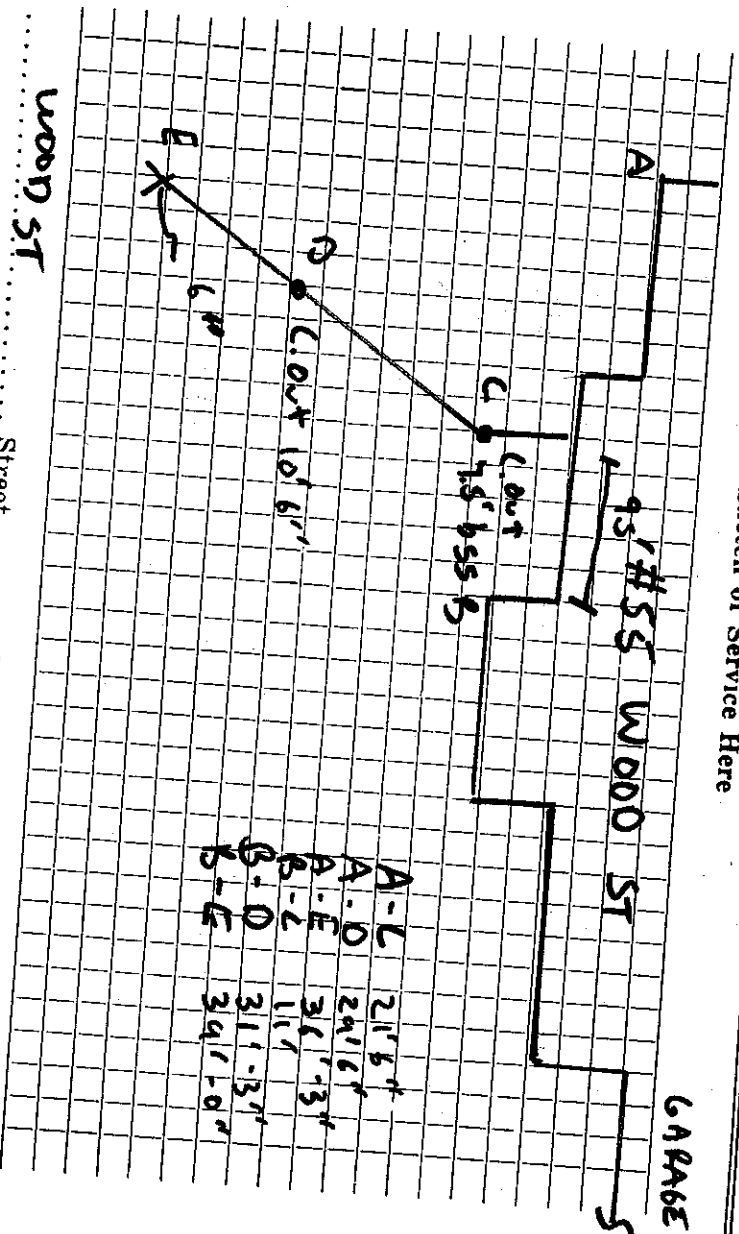

A-C	21'6"
A-D	24'6"
A-E	36'3"
B-C	11'
B-D	31'3"
B-E	34'0"

Connection made in WOOD ST Street. Work completed

Remarks:

Name Irving K. Zola

Service No. 130

Address 55 Wood St.

55 Wood Street

Location

Kind of Pipe

Size 6"

Size of Main 8"

~~Repair~~ ~~Renewal~~ New Service W.O. # Valeri #1523

Location APR 6 1970


Date	Material	Amount	Total	Date	Amount
11/13/69	Labor	95 52		11-5-69	215 00
12/10/69	"	26 20	121 72	4-6-70	8 23
10%	O/H.		12 17		206 07
18'	6" Transite pipe	88	15 84		
1	Adaptor		1 62		
1	Cap		1 63		
1/2	Bag cement	1.55	78		
1/4	Ton cold patch	5.85	5 85		
1	hot top				
2 1/2	Hrs. trucking	3.00	7 50		
1	" "		1 50		
4	" shovel	6.50	26 00		
1/2	" compressor	5.00	2 50		
1/2	" roller	3.00	1 50		
1	" loader		4 00		
	trailer		2 00		
12-16-69	6" Transite pipe		206 07		
70'	4" Cast Iron pipe				
39'					

DATE _____

TOWN OF LEXINGTON — BOARD OF PUBLIC WORKS

SEWER DIVISION

Sketch of Service Here **55**

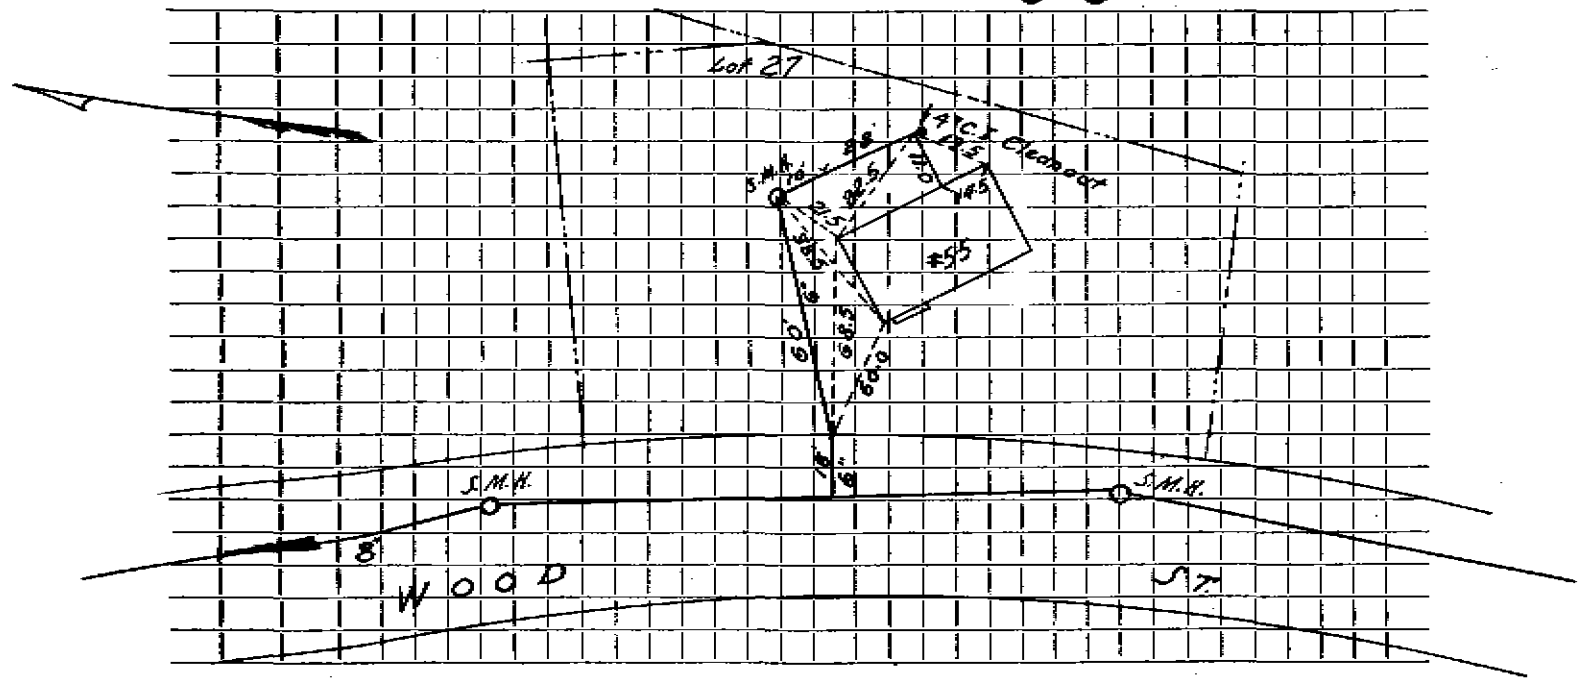

Connection made in Street. Work completed

Remarks:
.....
.....