




DATE 2/17/55

TOWN OF LEXINGTON — BOARD OF PUBLIC WORKS  
SEWER DIVISION

Sketch of Service Here **59**

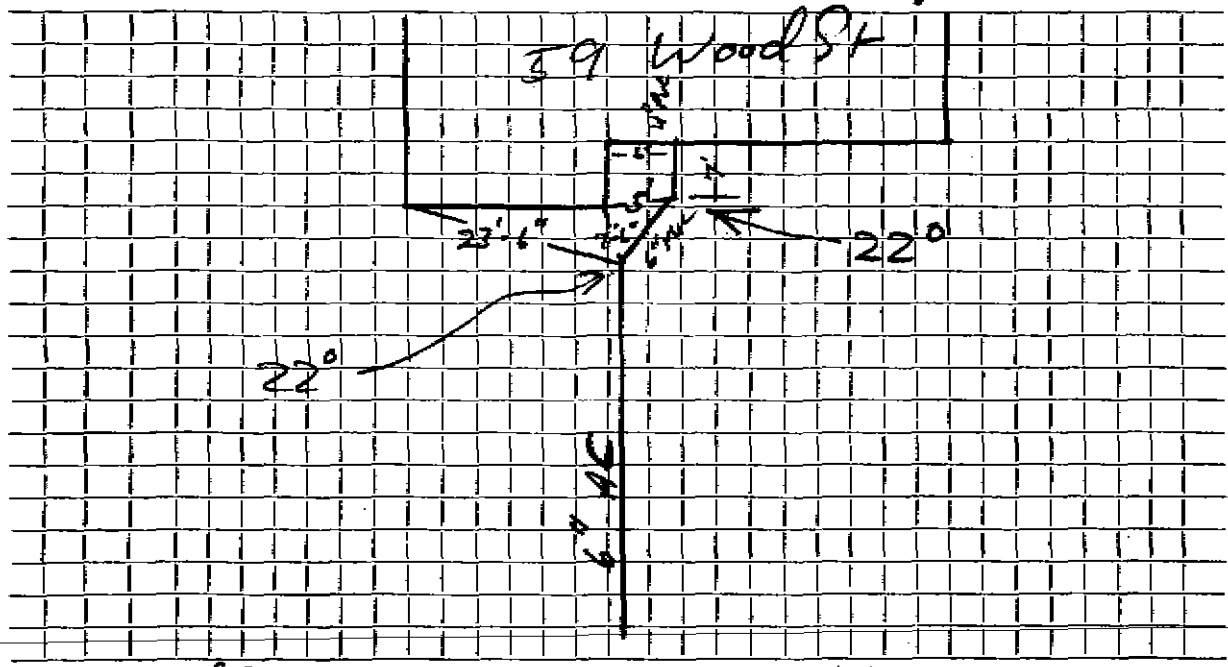

Connection made in Wood St Street. Work completed .....

Remarks: Original Service 5-1-61 (40'-6" TRANSIT, 1-22 1/2° BEND, 1-11 1/4° BEND)