

Name Philip Heidke

Service No.

48

Address 62 Wood Street

62 Wood Street

Location

Kind of Pipe

Size 6"

Size of Main 8"

Replacement - New Service W.O. 5598

Exp/ #317

Location

DEC 12 1977

Date	Material	Amount	Total	Date	Amount
7/28/77	Labor	66 22		7-15-77	350 00
	10% O.H.	6 62	72 84	12-11-77	47 83
	20' 6" Transite @ 1.51		30 20		303 18
	1 5' Nipple @ 1.76		8 80		
	1 6"x90° Elbow		5 56		
	1 6" Cap		5 10		
	3 Yds. Gravel @ 4.50		13 50		
	3 Ton Cold Patch @ 13.25		39 75		
	2 Hrs. Trucking @ 3.00		6 00		
	2 Hrs. Shovel @ 6.50		13 00		
	1½ Hr. Loader @ 4.00		6 00		
	Hot Top 19'x8'		101 36		
8-4-77	35' 6" Transite pipe		302 18		
	10' 4" Cast Iron				


TOWN OF LEXINGTON — BOARD OF PUBLIC WORKS

SEWER DIVISION

DATE _____

Sketch of Service Here

62

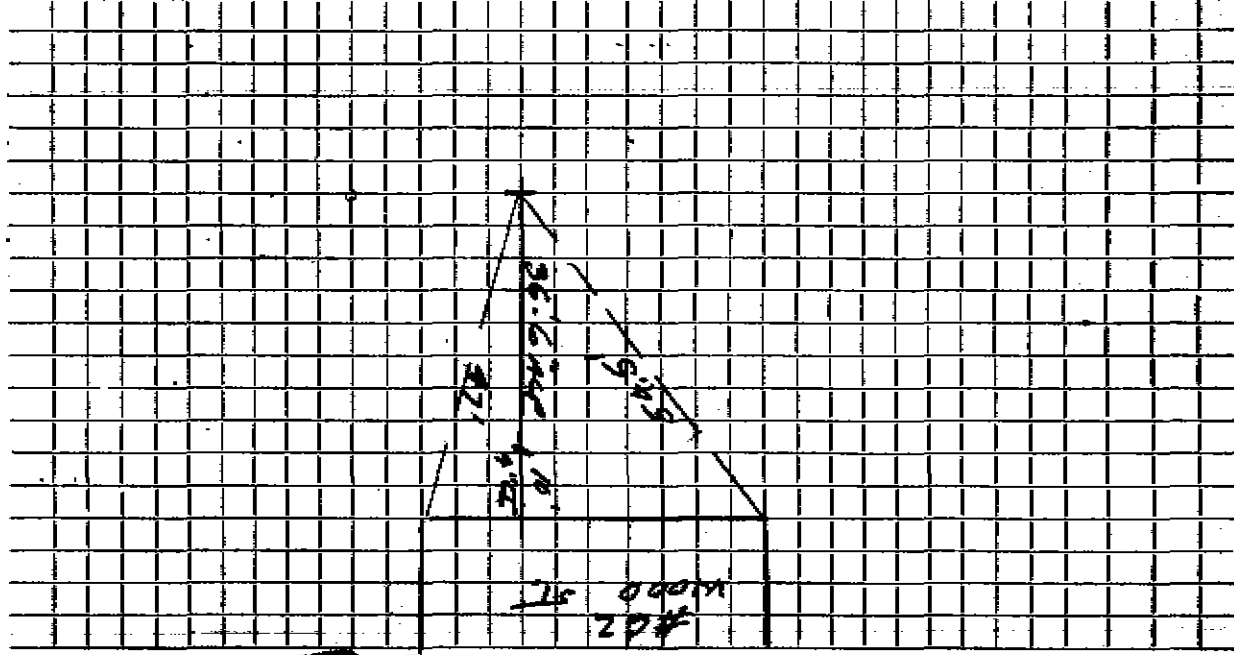

Work completed

Street

Wood

Connection made in

Remarks: