





TOWN OF LEXINGTON — BOARD OF PUBLIC WORKS

SEWER DIVISION

DATE

Sketch of Service Here

69

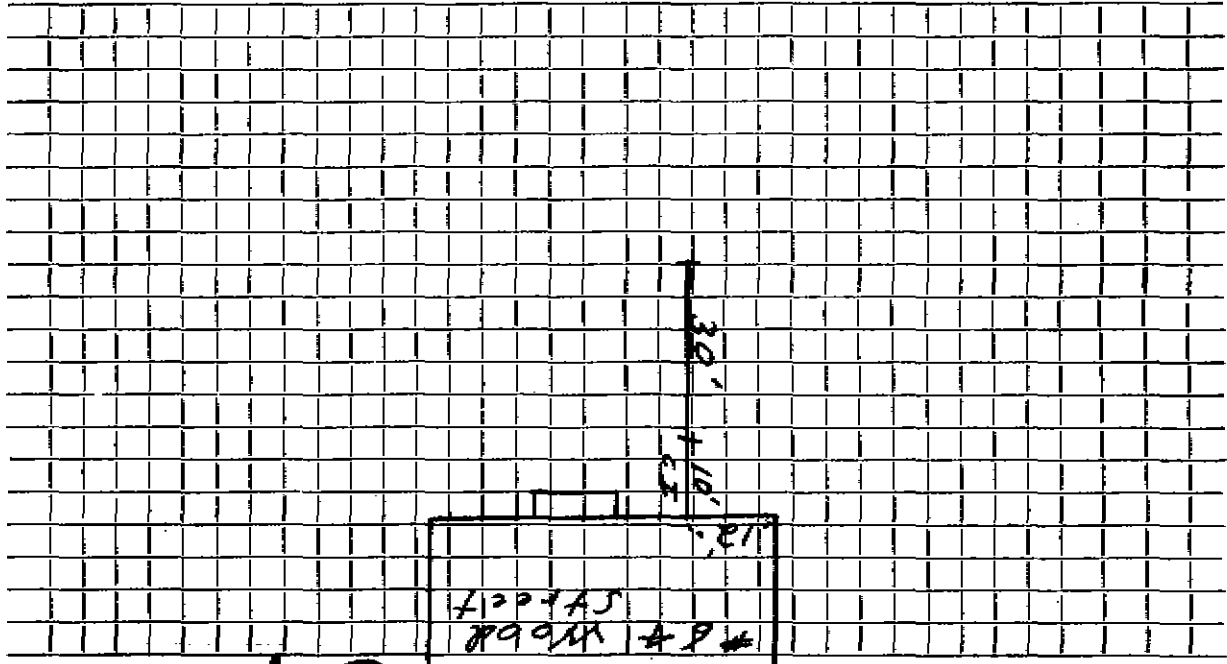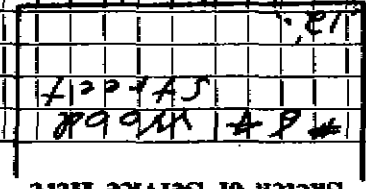

Remarks:

Connection made in *Wood* Street.

Work completed