

Name Phillip Heidke

Service No. 3

Address 66 Wood Street

66 Wood Street

Location

JUN 20 1977

Kind of Pipe

Size 6"

Size of Main 8"

Repair—Renewal—New Service

Dave Eagle #2900

Location


Date	Material	Amount	Total	Date	Amount
3/29/77	Labor 90.84			2/8/77	Deposit 390.00
3/29/77	police 36.00			6/20/77	Paid by WTK #1 54.93
3/23/77	police 21.00	147.84			Paid by WTK #8 8.50
	10%OH	14.78	162.62		452.53
30'	6" X 10' transite @ 1.75		52.50		
1	6" cap		3.80		
1	6" X 6" nipple		2.05		
1	6" X 90° elbow		6.56		
3	ton cold patch @ 12.50		37.50		
2	hrs. trucking @ 3.00		6.00		
3	hrs. shovel hrs. shovel @ 6.50		19.50		
	Patch Hot Top 27' X 9'		162.00		
			452.53		
3/30/77	40' 6" Transite Pipe				
	10' 4" Cast Iron				

TOWN OF LEXINGTON — BOARD OF PUBLIC WORKS

SEWER DIVISION

DATE _____

Sketch of Service Here
66

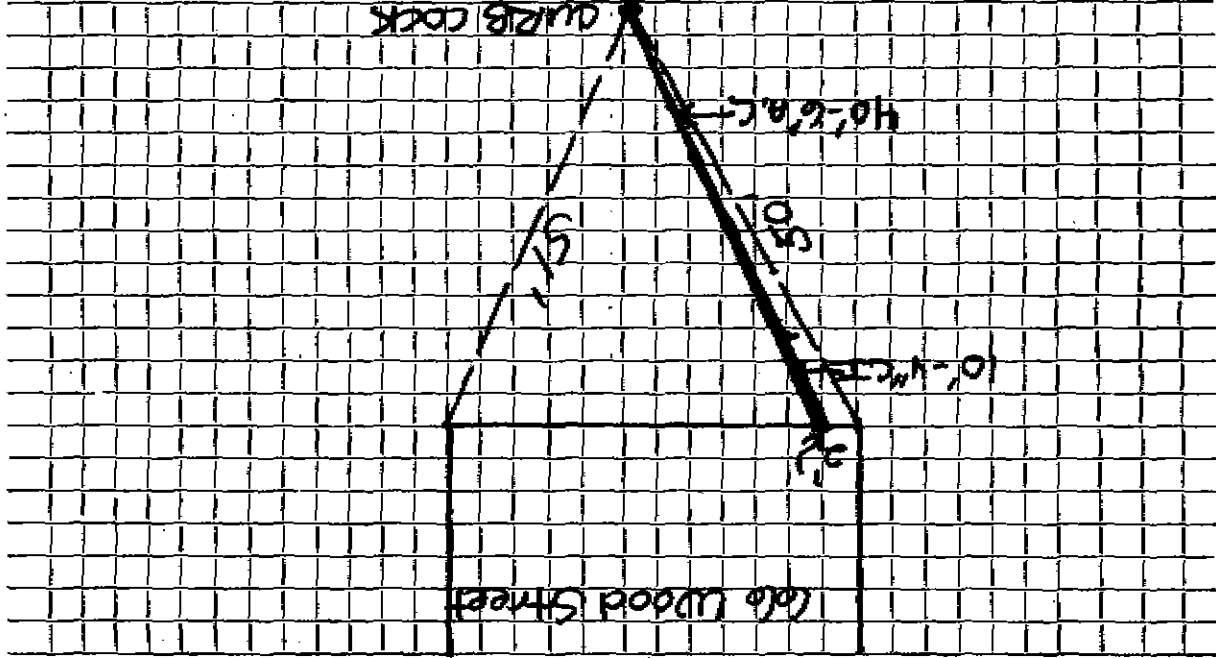

Connection made in _____ Street. Work completed _____

Remarks: _____