

Name

Service No.

Address 68 Wood Street

68 Wood Street

Location

Kind of Pipe

Size 6"

Size of Main 8"

Repair—Renewal—New Service

Location

Date	Material	Amount	Total	Date	Amount

DATE


TOWN OF LEXINGTON — BOARD OF PUBLIC WORKS

SEWER DIVISION

68

Sketch of Service Here

For Vac. Lot.
Access From
PATTERSON RD.

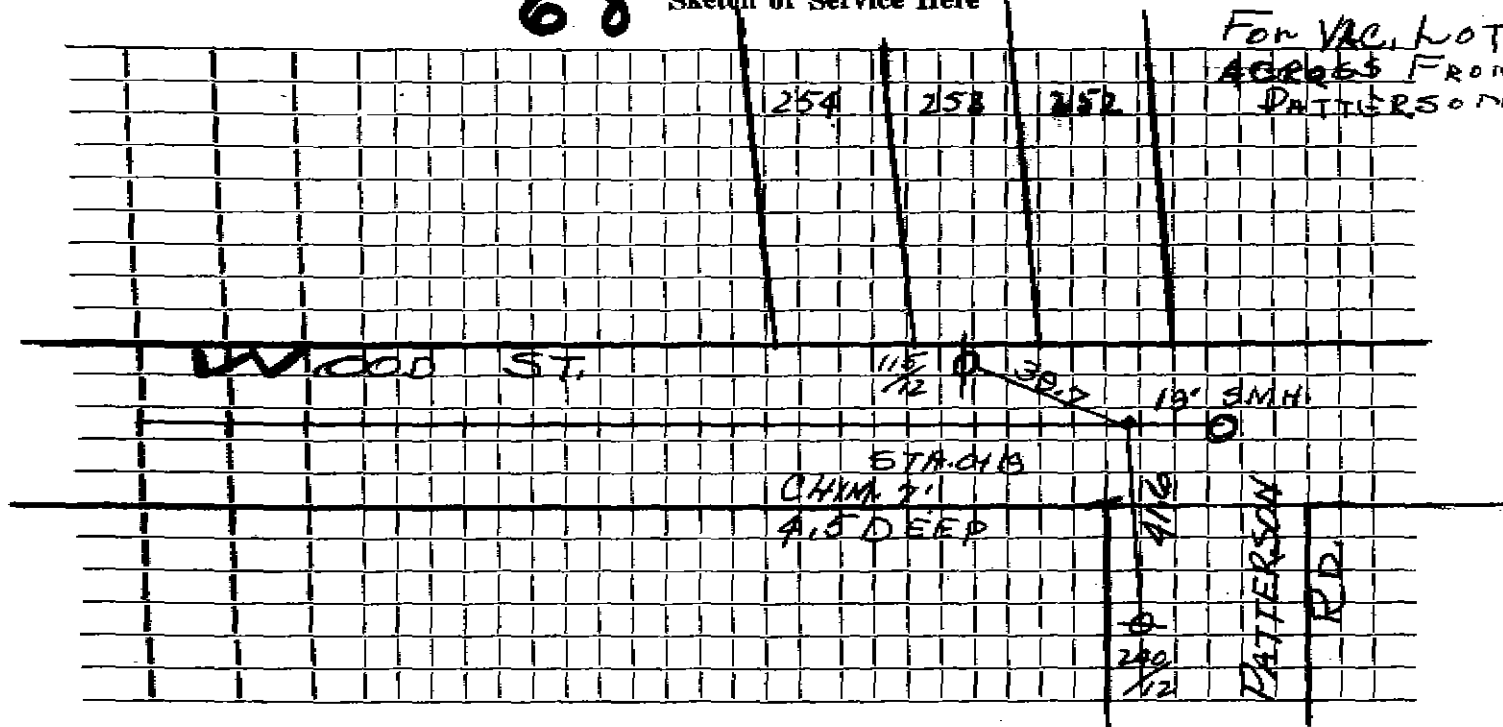

Connection made in Street. Work completed

Remarks:
.....
.....