

Name Philip Heidke

Service No. 15

Address 76 Wood Street Lexington, Mass.

JUN 20 1977

76 Wood Street

Location

Kind of Pipe

Size 6"

Size of Main 8"

~~Repair~~ Removal - New Service

Dave Eagle - permit no. 3159


Location

Date	Material	Amount	Total	Date	Amount	
5/4/77	Labor	66.27		4/21/77	Deposit	370.00
5/4/77	Police	45.00		6/30/77	Paid by WHC #6	46.41
5/23/77	Police	21.00	132.27			436.41
	10%oh	13.23	145.50			
	20' 6" X 10' trans. pipe @ 1.51		30.20			
	1 6" X 5' trans. nipple @ 1.76		8.80			
	1 6" X 6" X 6" trans. TEE		7.49			
	2 ton 3/4 stone @ 4.07		8.14			
	2 ton cold patch @ 13.30		26.60			
	2 hrs. trucking @ 3.00		6.00			
	2 hrs. shovel @ 6.50		13.00			
	Patch 26' X 11'		190.68			
			\$436.41			
5/20/77	58' 6" Transite Pipe					
	10' 4" cast iron					

DATE _____

TOWN OF LEXINGTON — BOARD OF PUBLIC WORKS
SEWER DIVISION

Sketch of Service Here **76**

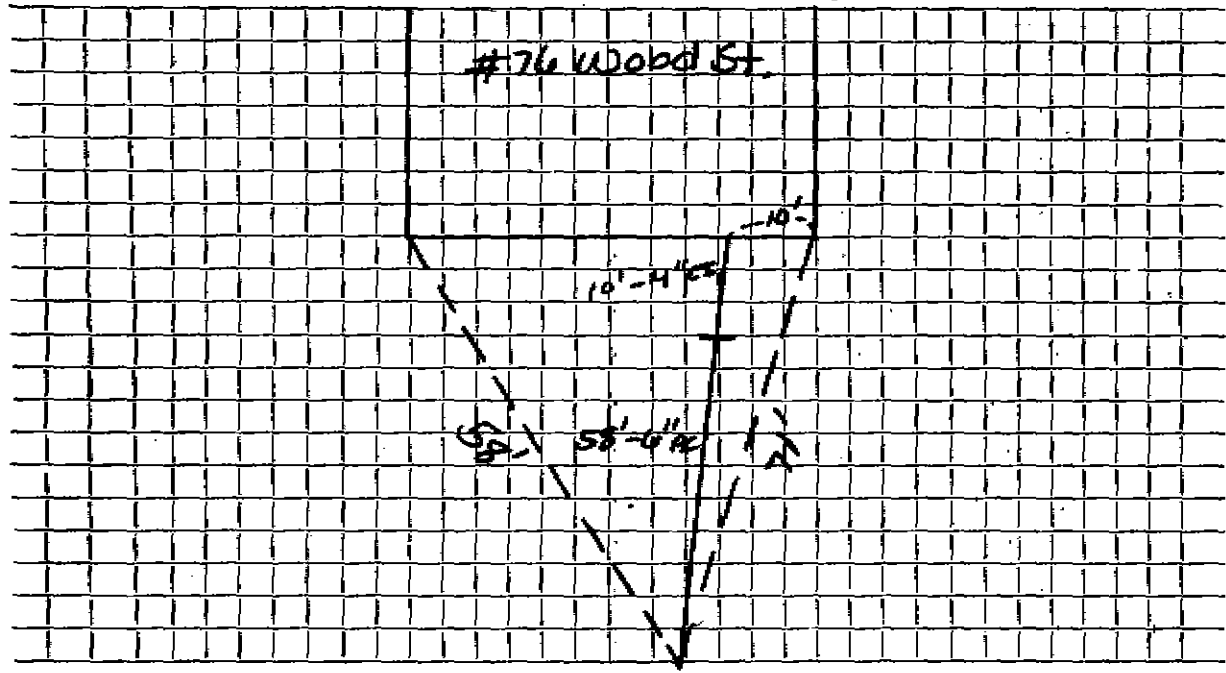

Connection made in Street. Work completed

Remarks: SEWER SERVICE TAPPED 12' UP FROM SMH - S'DEEP

.....
.....