

Name **Emmons Whitcomb**Service No. **2**Address **77 Wood Street****77 Wood Street**

Location

Kind of Pipe


Size **6"**Size of Main **8"**~~XXXXXXXXXX~~ New Service **WO #6449**Location **On 5-9-60**

Date	Material	Amount	Total	Date		Amount
4-4-60	Labor	45.44		4-4-60	Deposit	275.00
	10% O.H.	4.54	49.98	6-9-60	Refund	162.85
46	6" Transite pipe @.78		35.88			<u>112.15</u>
1	6" Transite Elbow 45°		2.79		OUTSIDE	
2	hrs. Town Shovel @6.50		13.00	7/11/78	labor	
2	hrs. Trucking @.75		1.50	5'	transite nipple	
9 x 3	Patch		9.00	2'	trans. nipple	
			<u>112.15</u>	1	6" nipples	
				3	6" collars	
				1	bag cement	
				6	bricks	
				45'	collar bend	
				45	sweep	
				2	hr. trucking	

DATE _____

TOWN OF LEXINGTON — BOARD OF PUBLIC WORKS
SEWER DIVISION

Sketch of Service Here **77**

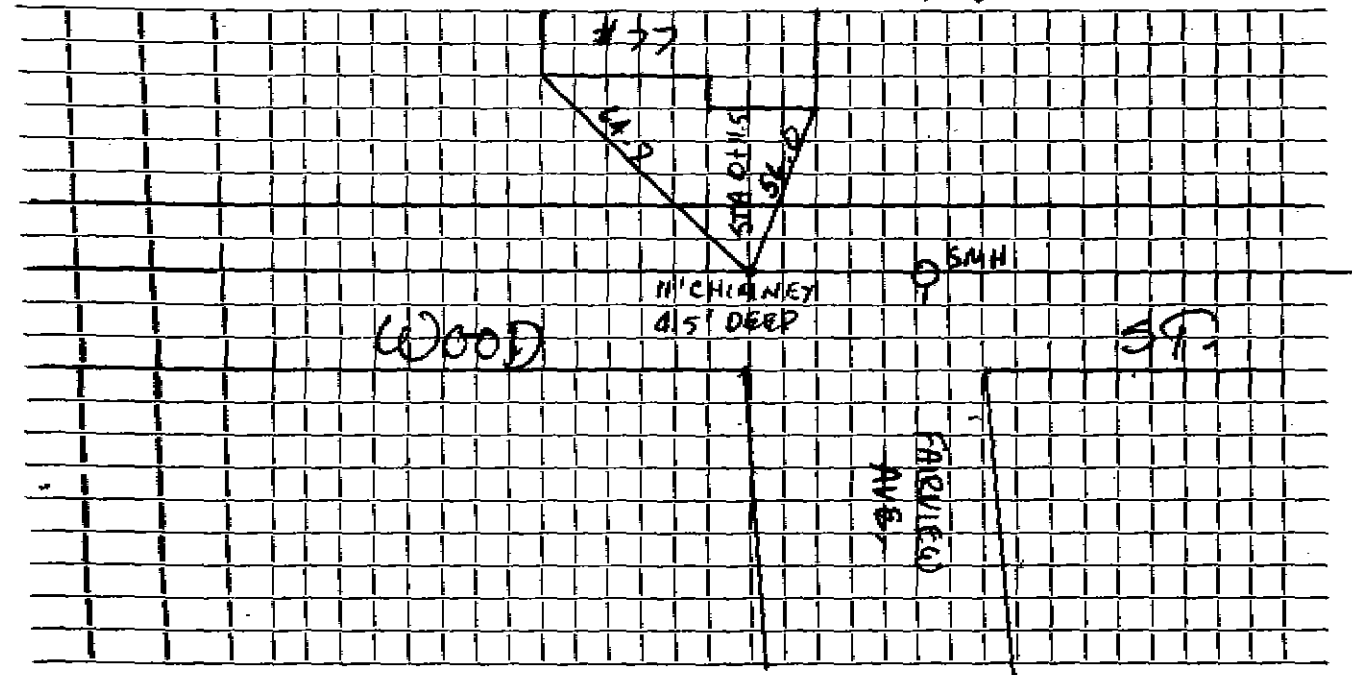

Connection made in Street. Work completed

Remarks:
.....
.....