

Name

Philip Halcke

Service No. 42

Address

78 Wood Street

78 Wood Street

Location

Kind of Pipe

Size 6"

Size of Main 8"

Requisition—New Service N. O. #5616

Location

DEC 12 1977


| Date    | Material                 | Amount    | Total     | Date    | Amount |
|---------|--------------------------|-----------|-----------|---------|--------|
| 7/28/77 | Labor 102.96             |           |           | 6-28-77 | 410.00 |
|         | 10% O.H. 10.29           | \$ 113.25 |           | 11-1-77 | 307.57 |
|         | 30' 6" Transit @ 1.51    | 45.30     |           |         |        |
|         | 1 6" x 90° Elbow         | 5.65      |           |         |        |
|         | 1 6" Cap                 | 5.10      |           |         |        |
|         | 3 Yards Gravel @ 4.50    | 13.50     |           |         |        |
|         | 3 Ton Cold Patch @ 13.25 | 39.75     |           |         |        |
|         | 2 Hrs. Trucking @ 3.00   | 6.00      |           |         |        |
|         | 1 1/2 Hrs. Loader @ 4.00 | 6.00      |           |         |        |
|         | 2 Hrs. Shovel @ 6.50     | 13.00     |           |         |        |
|         | Hot Top - 24' x 10'      | 160.00    | \$ 407.57 |         |        |

Report  
Paid by *[Signature]*

**TOWN OF LEXINGTON — BOARD OF PUBLIC WORKS**

**SEWER DIVISION**

Sketch of Service Here

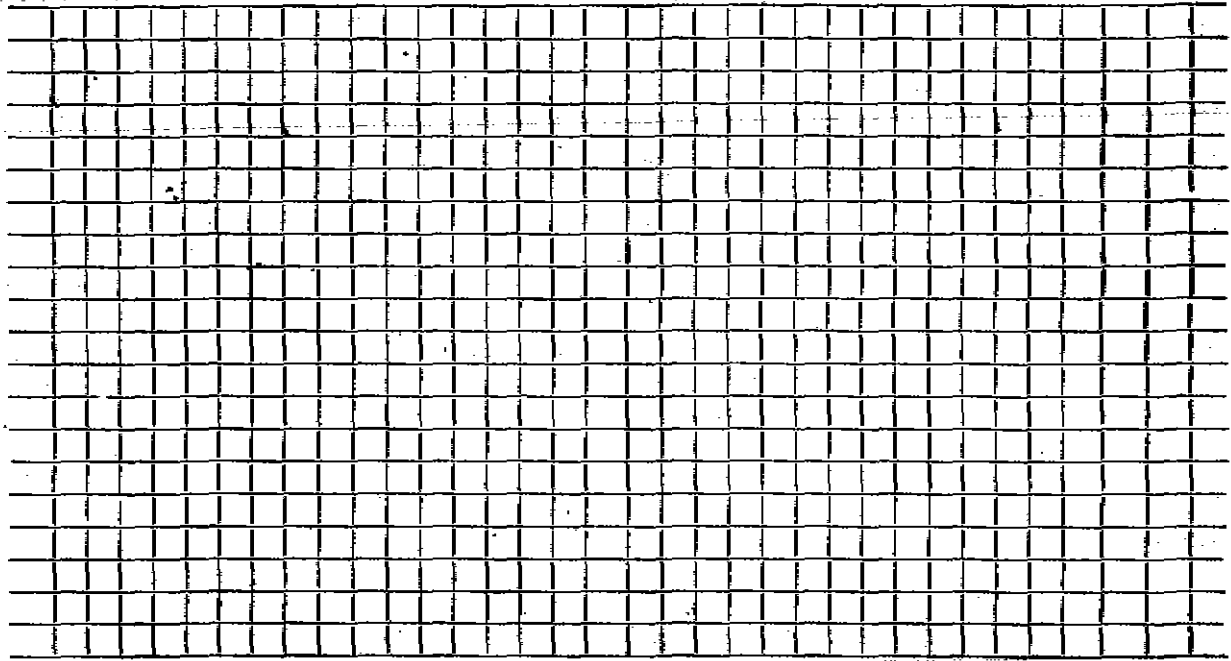

Work completed

Street

Connection made in

Remarks: