

Service No.

Name Homes Realty Corp.

Address # 80 WOOD ST.

80 Wood Street

Location

Kind of Pipe 6" PVC

Size 6"

Size of Main 8"

Repair—Renewal—New Service

McLaughlin #0204


Location

Date	Material	Amount	Total	Date	Amount
9/1	6 LF 4" PVC				
	86 LF 6" PVC				
	4" X 6" FERNCO				
	3' CHIMNEY				

DATE 9/1/92

TOWN OF LEXINGTON — BOARD OF PUBLIC WORKS
SEWER DIVISION

Sketch of Service Here **80**

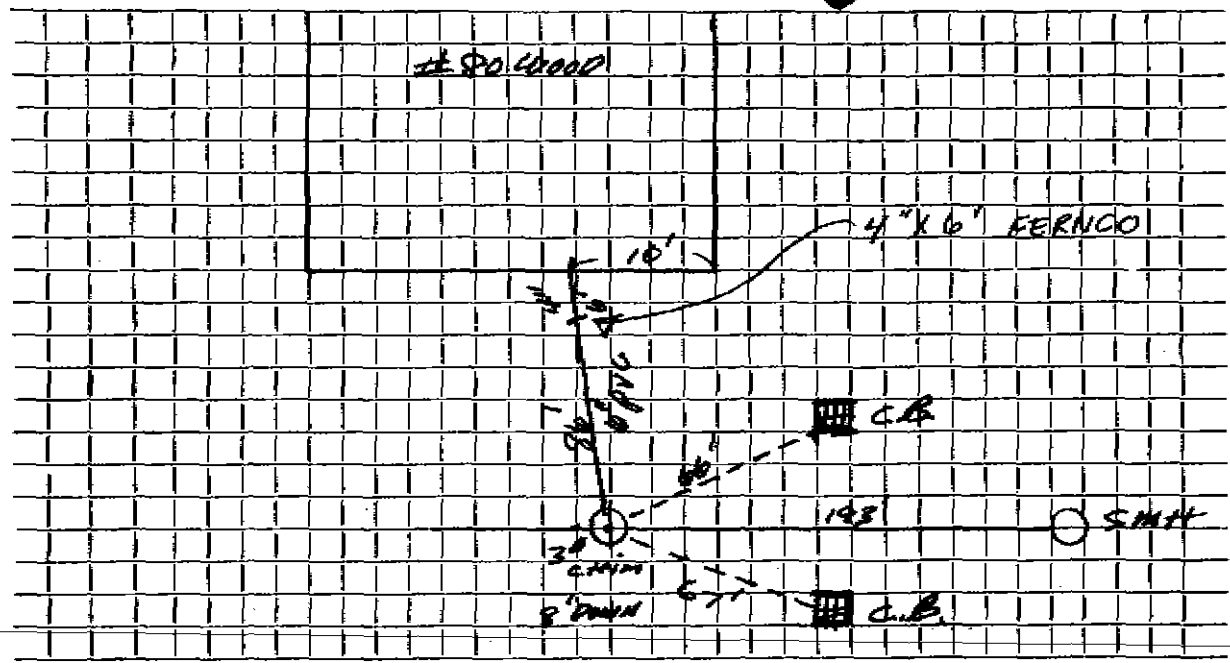

Connection made in # 80 WOOD Street. Work completed BY: McLAUGHLIN

Remarks: INSPECTED: CRG