


TOWN OF LEXINGTON — BOARD OF PUBLIC WORKS

SEWER DIVISION

Sketch of Service Here

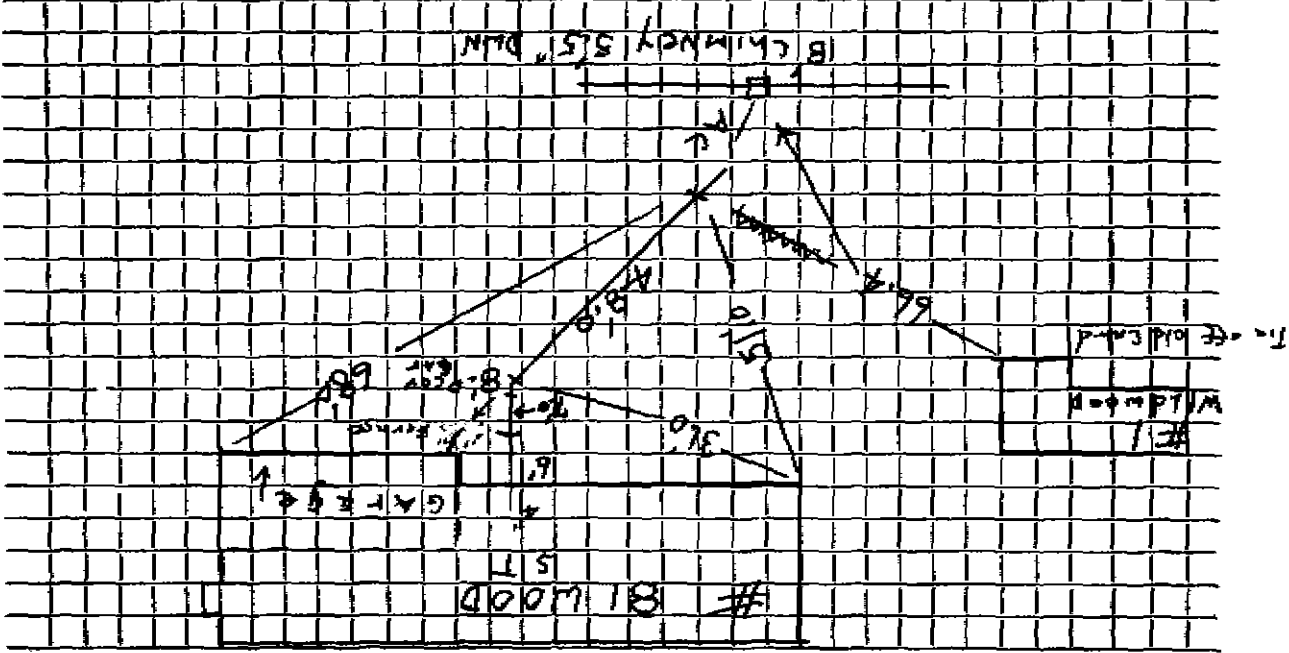

Connection made in STA 1+53
 Street.
 Remarks:

Work completed 6/4/07 I. Mitchell