


DATE Nov. 20, 1980

TOWN OF LEXINGTON — BOARD OF PUBLIC WORKS
SEWER DIVISION

Sketch of Service Here **86**

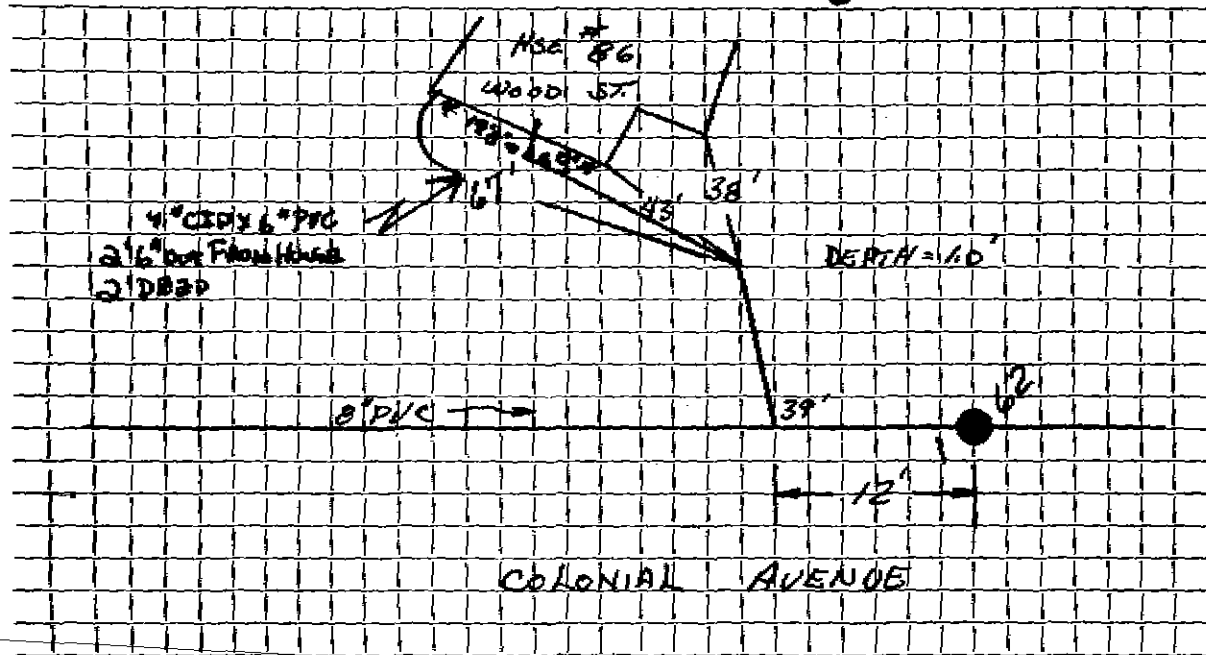

Connection made in COLONIAL Street. Work completed Nov. 20, 1980

Remarks:

.....

.....