

Name **L.E. Swett Jr., Inc.**

Service No. **90**

Address **88 Reed Street**

(SAME SERVICE FOR 80 WOOD STREET)

Location

Kind of Pipe

Size **6"**

Size of Main **8"**

Repair—Renewal—New Service **Invoice #3495 W.O. 1957**

Location


JUL 7 1980

Date	Material	Amount	Total	Date	Amount
12-6-79	Labor	293.48		10-30-79	Deposit
12-5-79	Police	72.00	365.48	7-7-80	Paid by S.W.M.H. 93.23
	108 O.H.		96.55		991.23
20'	6" Transit 01.62		32.40		
1	6" Elbow		9.28		
2	8" Pipe Cement		9.20		
108	Red Brick		12.95		
7	Barrel Blocks		5.88		
1	Manhole		232.32		
1	Frame & Cover		180.00		
2	3' Hoppers		15.00		
2	6" Pipe		5.00		
7	Manhole Framing		21.00		
6	Manhole Inset		30.00		
	Net Wgt P. I. 20'		25.00		
			991.23		
					Bill sent

TOWN OF LEXINGTON — BOARD OF PUBLIC WORKS

SEWER DIVISION

Sketch of Service Here

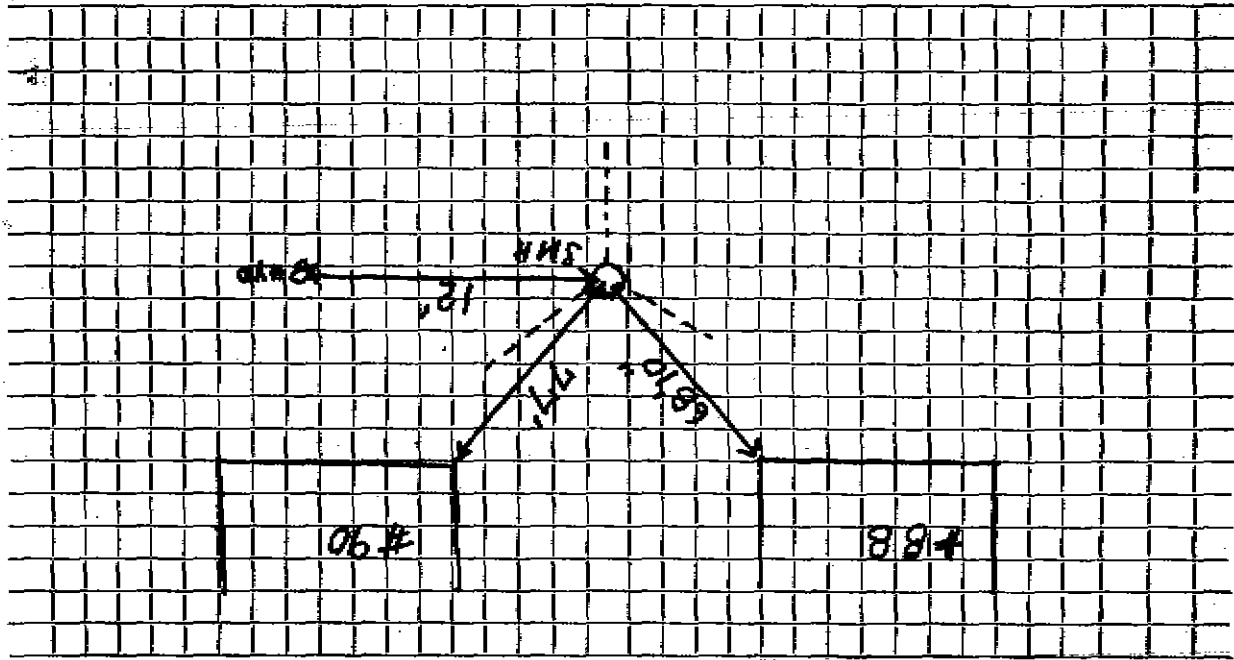

Connection made in

Street

Work completed

Remarks: