

Name **L.H. Bennett Jr., Inc.**

Service No. **83**

Address **20 Wood Street**

(SAME SERVICE FOR 400 WOOD STREET)

Location

Kind of Pipe

Size **6"**

Size of Main **8"**

Repair—Renewal—New Service **Account #3086 R.O. #889**

Location

JUL 7 1980


Date	Material	Amount	Total	Date	Amount
12-6-79	Labor	293.45		10-30-79	Deposit
12-5-79	Police	72.00	365.45	7-2-80	Paid by S.H.P. #89
	10% O.N.		36.55		
			402.00		
20'	6" Transite	61.63	32.00		
2	6" Elbow		9.20		
2	Bags Cement		9.20		
100	Red Brick		12.00		
7	Barrel Blocks		5.00		
1	Manhole		222.23		
1	Frame & Cover		124.50		
2	2' Nipples		15.00		
2	6" Flange		5.00		
7	Spun Trucking		21.00		
6	Hours Machine		20.00		
	Sub 20' 7' x 30'		12.00		

TOWN OF LEXINGTON — BOARD OF PUBLIC WORKS

SEWER DIVISION

DATE

Sketch of Service Here

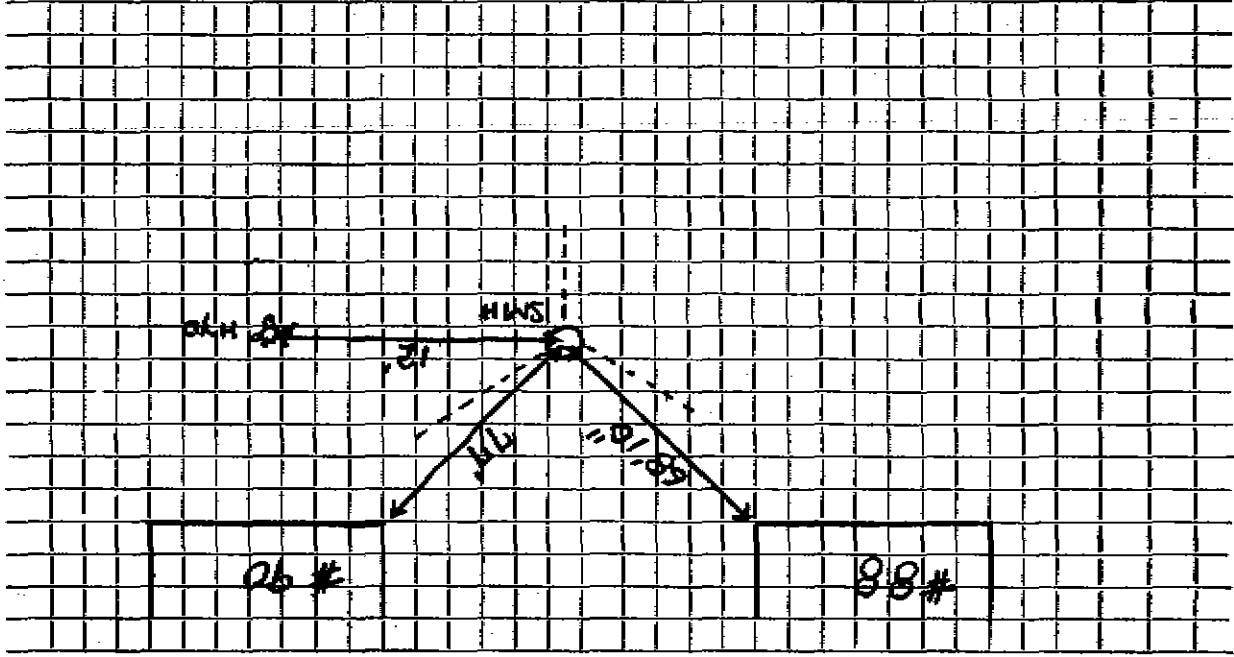

Connection made in

Street.

Work completed

Remarks: