


DATE _____

TOWN OF LEXINGTON — BOARD OF PUBLIC WORKS
SEWER DIVISION

94

Sketch of Service Here

S.S. FOR # 94 WOOD ST.

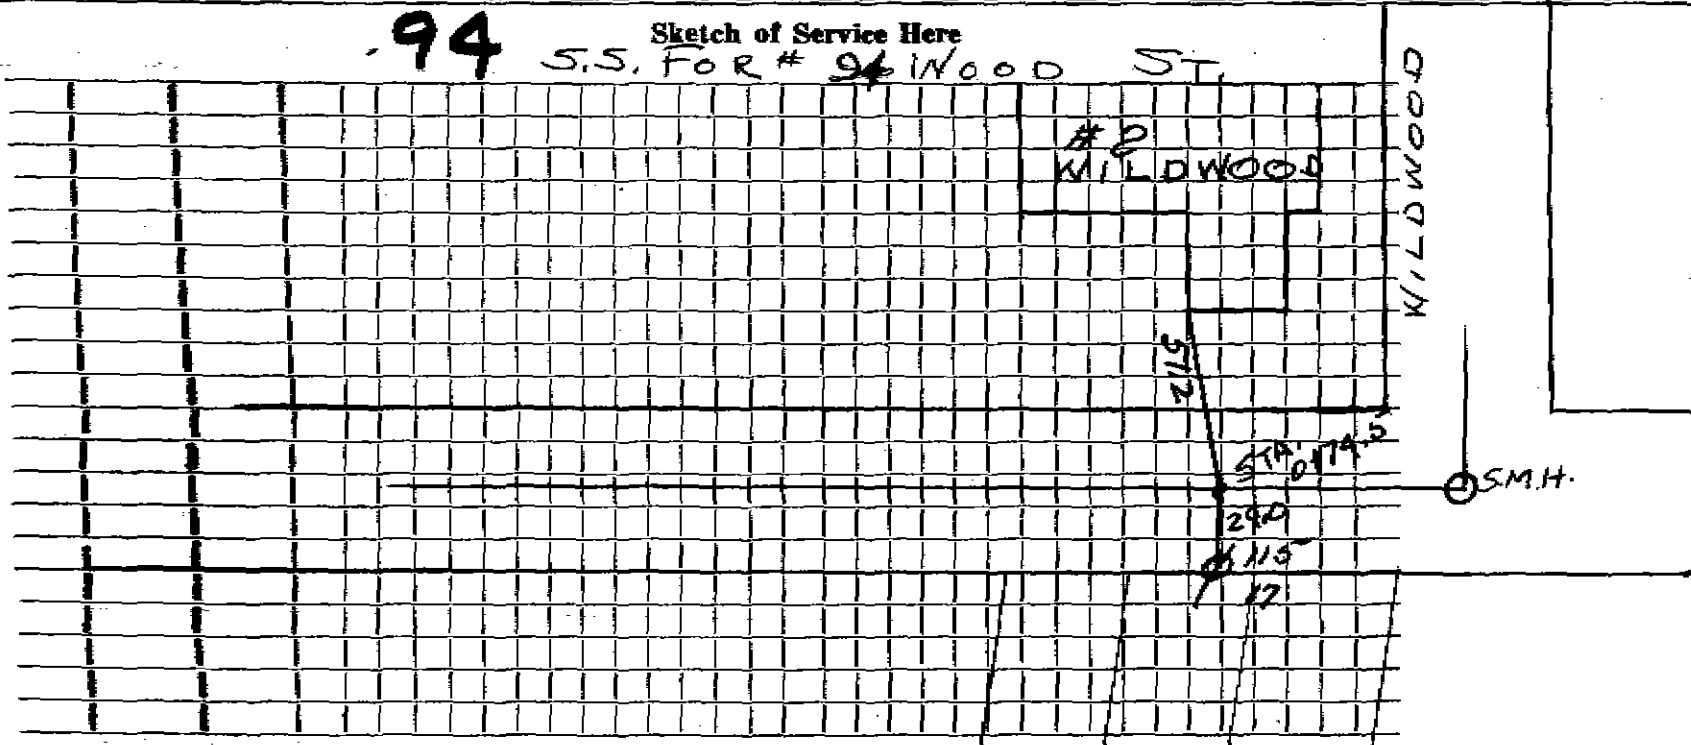

Connection made in Street. Work completed

Remarks:

318 319 320