



DATE \_\_\_\_\_


TOWN OF LEXINGTON — BOARD OF PUBLIC WORKS

SEWER DIVISION

96

Sketch of Service Here

SS. For #96

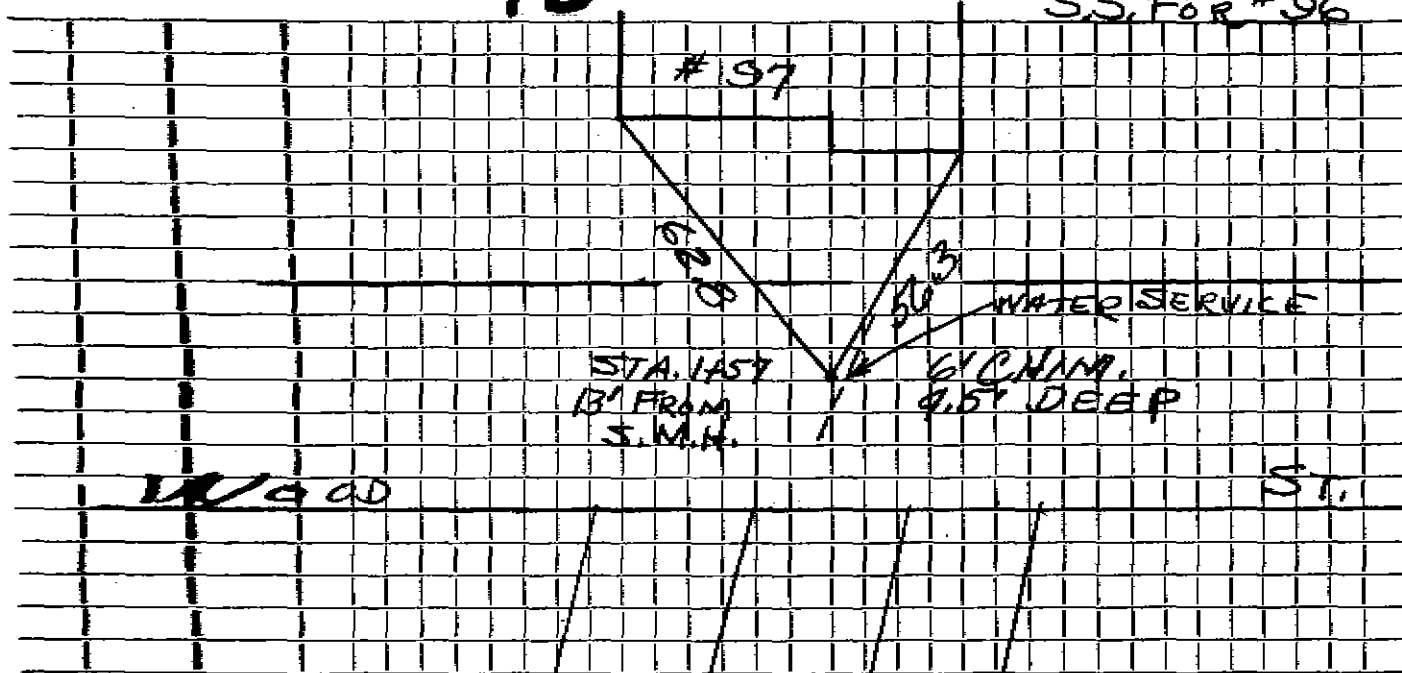

STA. 1457  
13' FROM  
S.M.H.

6" CORR.  
9.5' DEEP

Connection made in ..... Street. Work completed .....

Remarks: .....

3/5 3/6 3/7

Name Lexington Housing Authority c/o Temple Scanlon

Service No. 54110

Address 96 Wood St. Lexington, Mass.

Location

Kind of Pipe

Size

Size of Main

Repair—Renewal—New Service WO #3868

Location

Date	Material	Amount	Total	Date		Amount
4/2/76	labor	121. 60		8-20-76	paid	201. 92
	10%OH	12. 20	133. 80			
	42' transite pipe @ 1.48		62. 16		OUTSIDE	
	2hr. truck @ 3.00		6. 00	30'	6" pipe	44. 40
			201. 96	1	6"X6"X6" transite	7. 49
				1	6" adapter	4. 38
					6" nipple	1. 71
				1/2	bag cement	1. 50
				14	red bricks	1. 82
						61. 30

**TOWN OF LEXINGTON — BOARD OF PUBLIC WORKS**

**SEWER DIVISION**

DATE


Sketch of Service Here

A large grid area for sketching service details, consisting of approximately 20 columns and 25 rows of small squares.

Street. Work completed

Connection made in

Remarks:

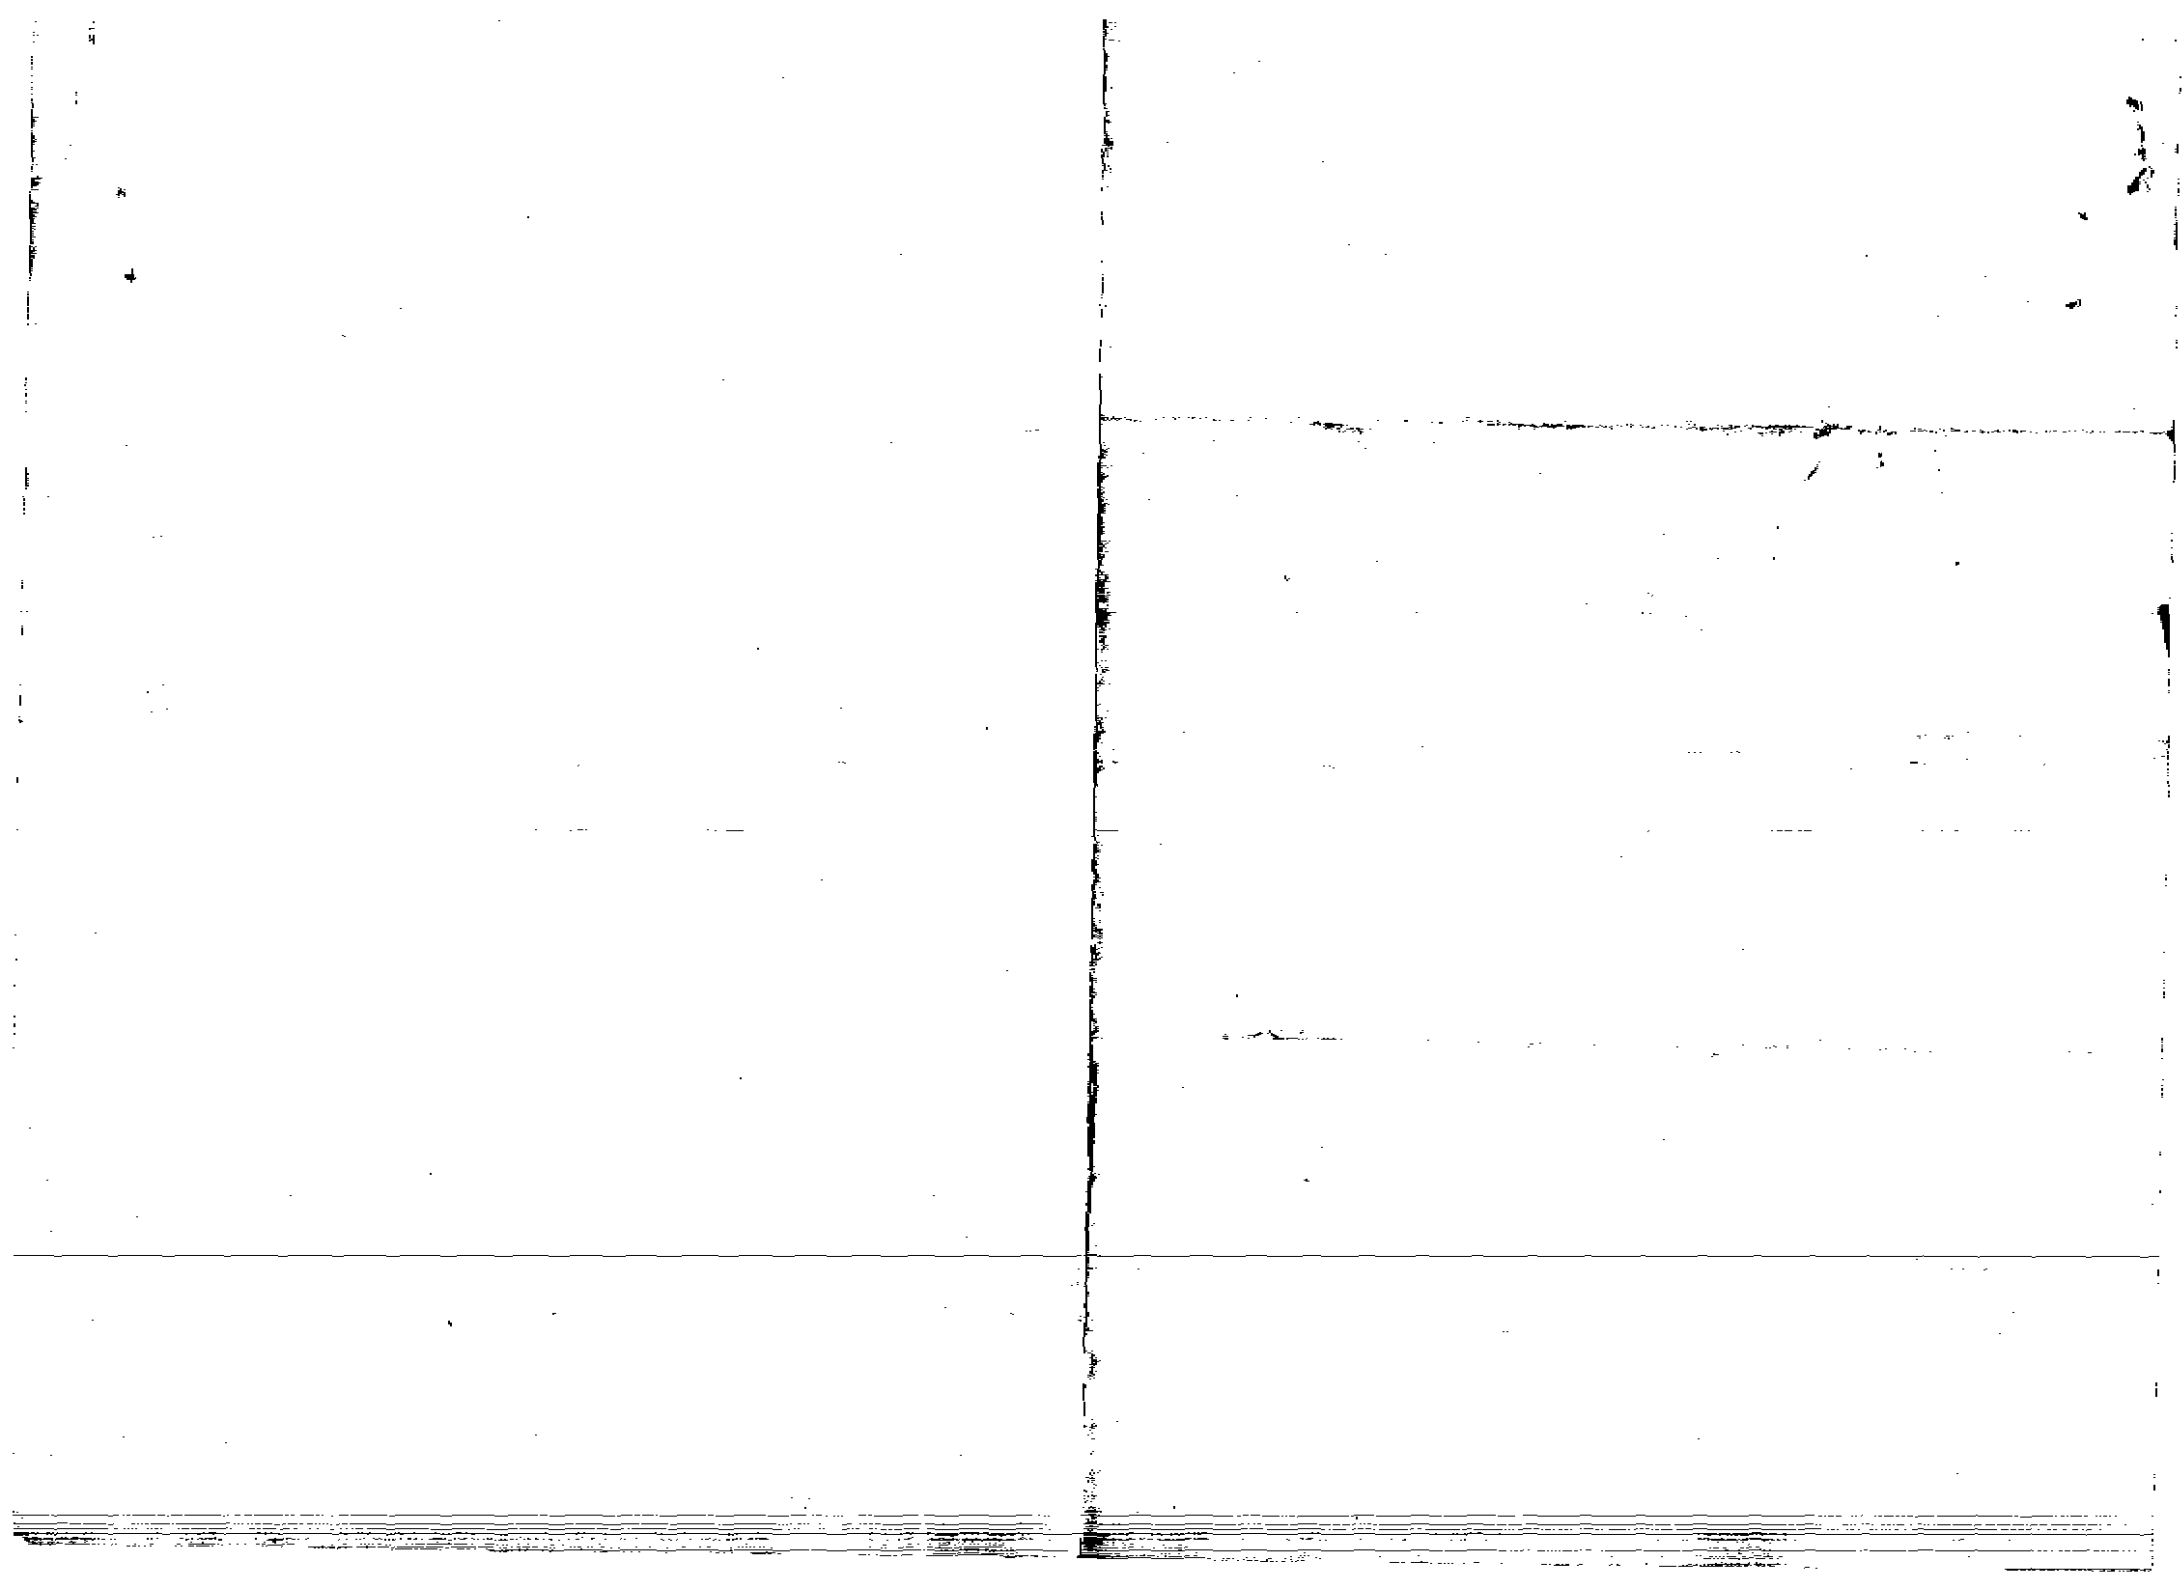

LEXINGTON HOUSING AUTHORITY

16 WILLIAM ROGER GREELEY VILLAGE, LEXINGTON, MASSACHUSETTS 02173



Tel. 861-0261 Office  
861-8512 Maintenance

Temple E. Scanlon  
Executive Director

December 4, 1975

Joseph O. Rooney, Chairman  
Richard Beamon, Vice Chairman  
Mary E. Shunney, Treasurer  
William A. Melbye, Asst. Treasurer  
William Spencer Sullivan, Asst. Secretary

John J. McSweeney, Director  
Public Works Department  
Town of Lexington  
Town Offices  
Lexington, Massachusetts 02173

RE: Water application for 96 Wood St.

Dear Mr. McSweeney:

The Lexington Housing Authority would appreciate the Town proceeding with the laying of the water and sewer connections from the mains to our property line without our having to post a deposit as requested in your letter of December 1, 1975.

It would greatly simplify our bookkeeping and audit procedures if we were to receive one billing for all the work done by your department at the completion of your part of the installation.

Payment in full will be made upon receipt of your bill.

Yours truly,

*Temple E. Scanlon*  
Temple E. Scanlon

FES/pm

*Install services without payment*

*per Mr. McSweeney per Mary*

RECEIVED  
PUBLIC WORKS / ENGINEERING

DEC 5 1975

BY