

Name William A. Hobbs

74

Address 97 Wood St.
97 Wood Street

Location

Kind of Pipe

Size 6"

Size of End-join 8"

Replacements - New Service

Location

Case No 9-25-61


Date	Material	Amount	Total	Date	Amount
7-8-61	Labor	89.68		6-17-61	Deposit
	10% O.H.	8.97	98.65	8-5-61	paid
	64' 6" Transite pipe @ .78		49.92		
3	11 1/2 Transite Bends @ 2.24		6.72		
1	6" 90° Transite Elbow		5.40		
1	Duplex Adapter		1.90		
2	22 1/2 Transite Bend @ 6.21		12.42		
6	x 3 Patch		6.00		
2	hrs. Trucking @ 3.00		6.00		
2	hrs. Pippin Shovel @ 5.00		10.00		
1	hr. Insley Shovel @ 6.50		6.50		
			203.61		
				8-11-61	sent 3.31

DATE

TOWN OF LEXINGTON — BOARD OF PUBLIC WORKS SEWER DIVISION

Sketch of Service Here

97

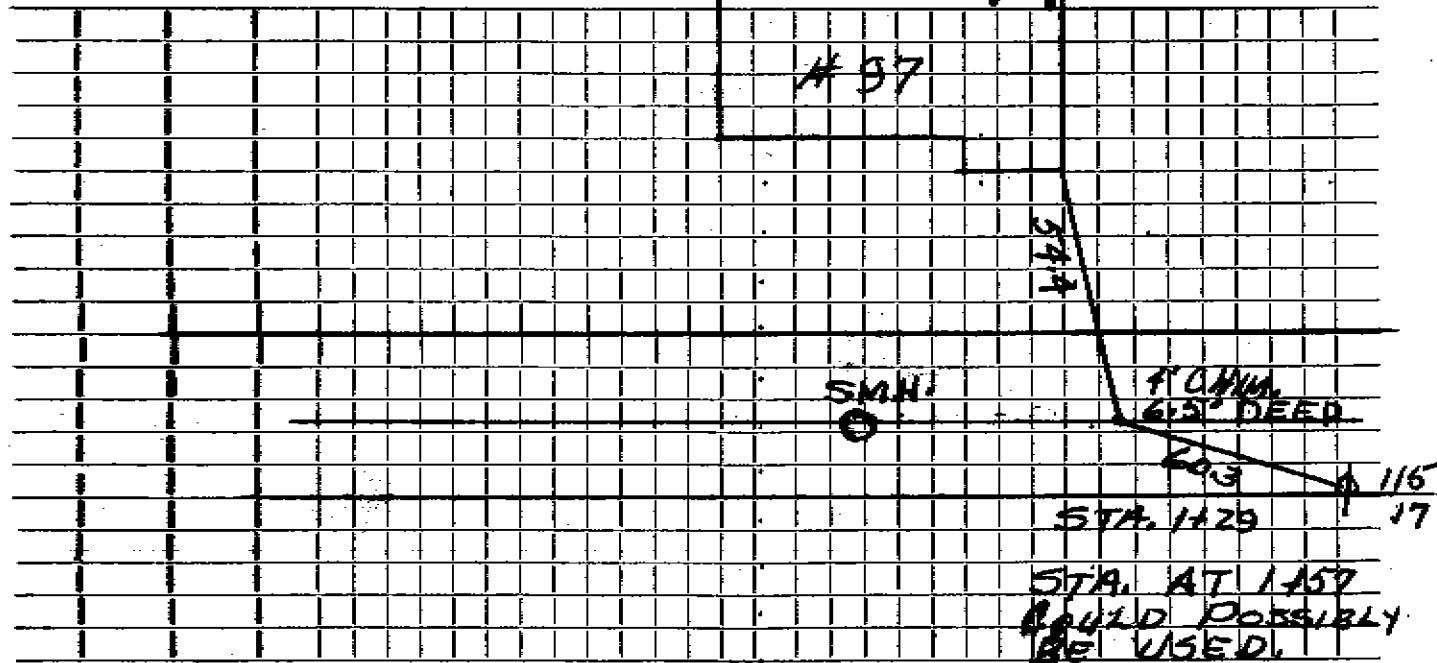

02

Connection made in Street. Work completed

Remarks:
.....
.....