


TOWN OF LEXINGTON — BOARD OF PUBLIC WORKS

SEWER DIVISION

DATE _____

Sketch of Service Here

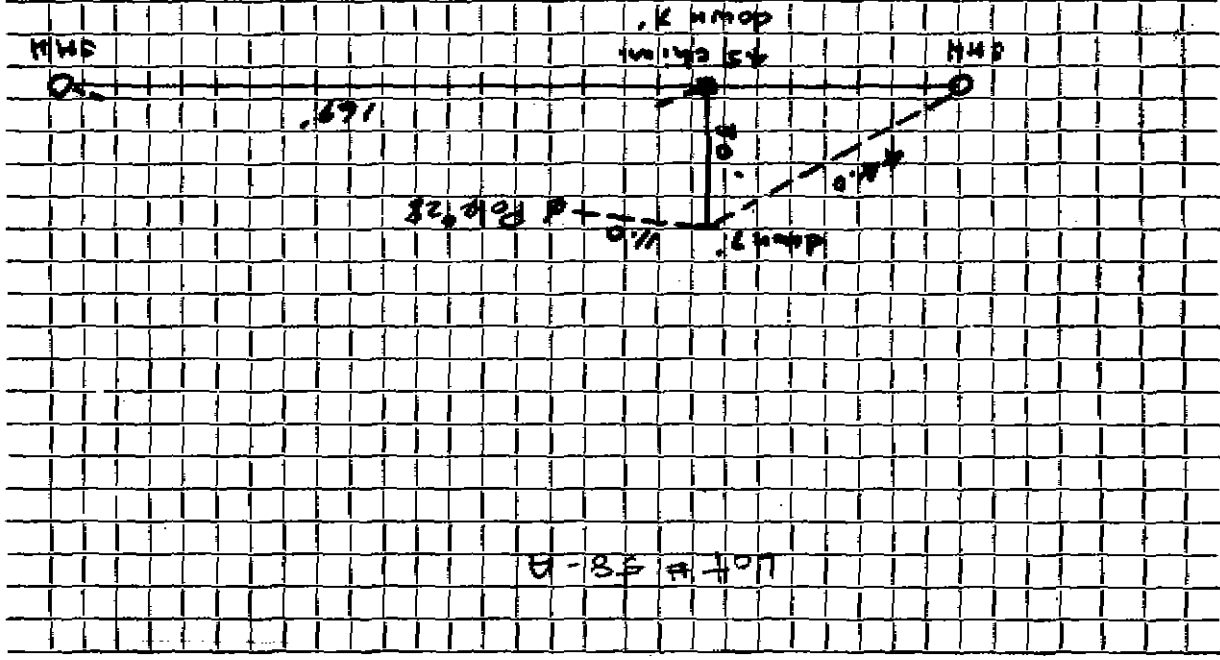

Work completed _____

Street _____

Connection made in Wood St.

Remarks: _____