


TOWN OF LEXINGTON — BOARD OF PUBLIC WORKS
 DATE _____

SEWER DIVISION

Sketch of Service Here

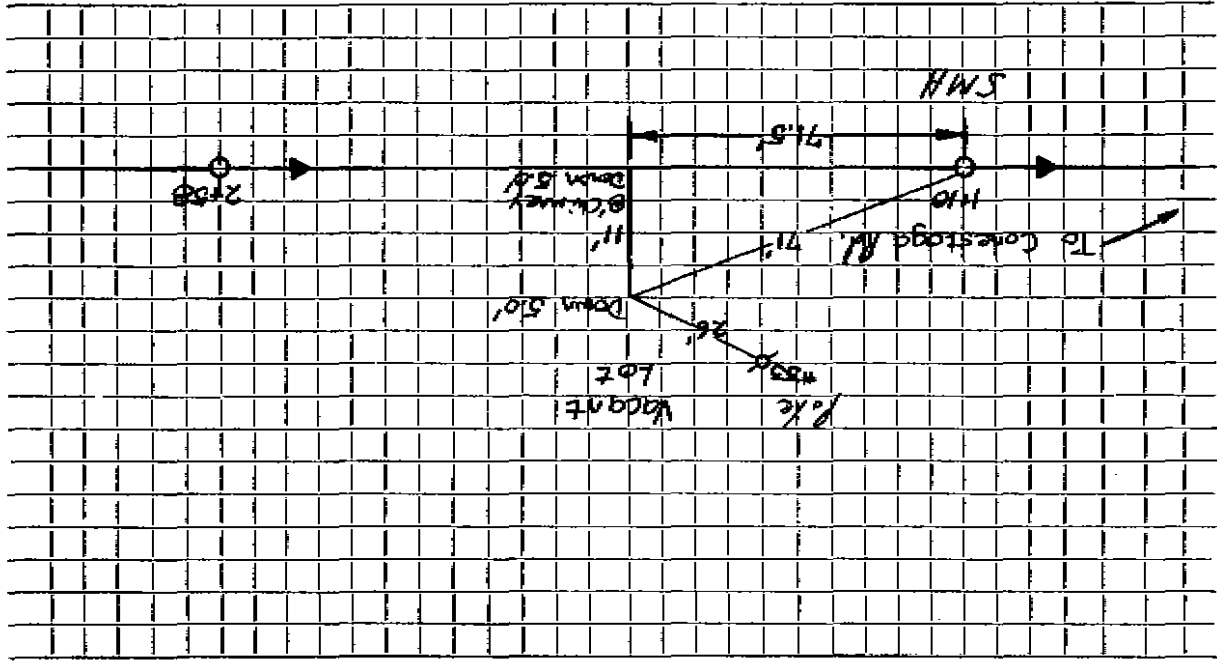

Connection made in Wood Street. Work completed

Remarks: M.I.T. Party