


SEWER DIVISION

Sketch of Service Here

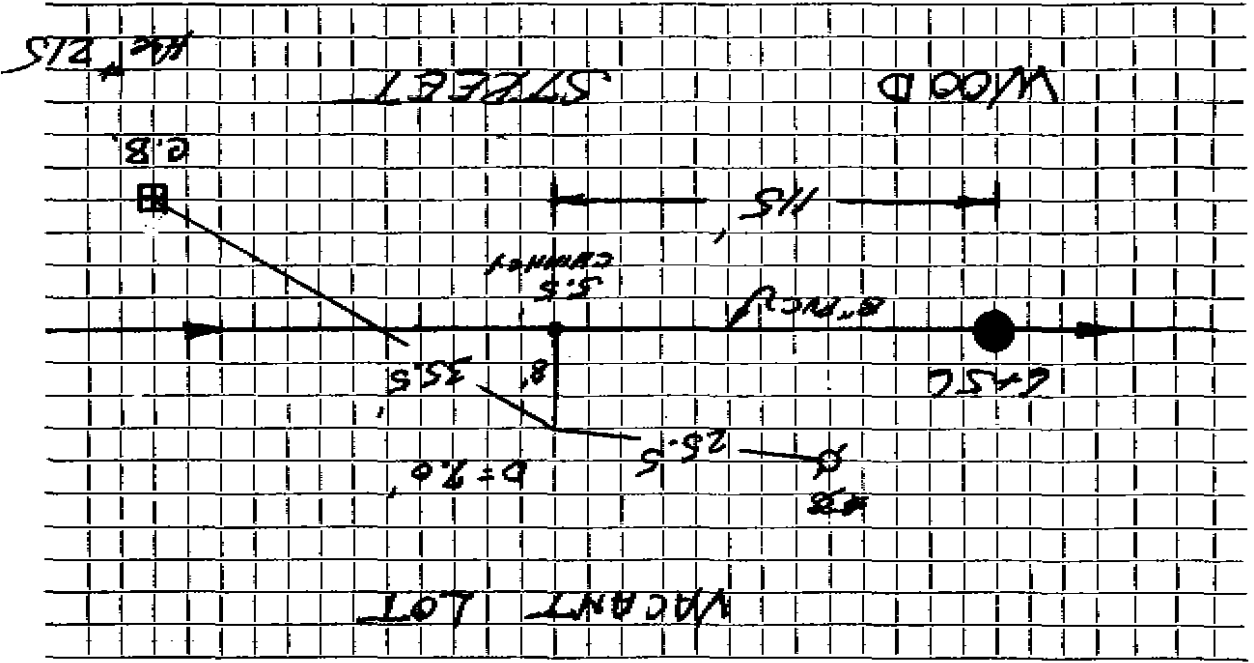

Work completed 7/18/83

Street


WOOD

Connection made in

Remarks: M.I.T. Property

DATE _____
TOWN OF LEXINGTON — BOARD OF PUBLIC WORKS
SEWER DIVISION

Sketch of Service Here

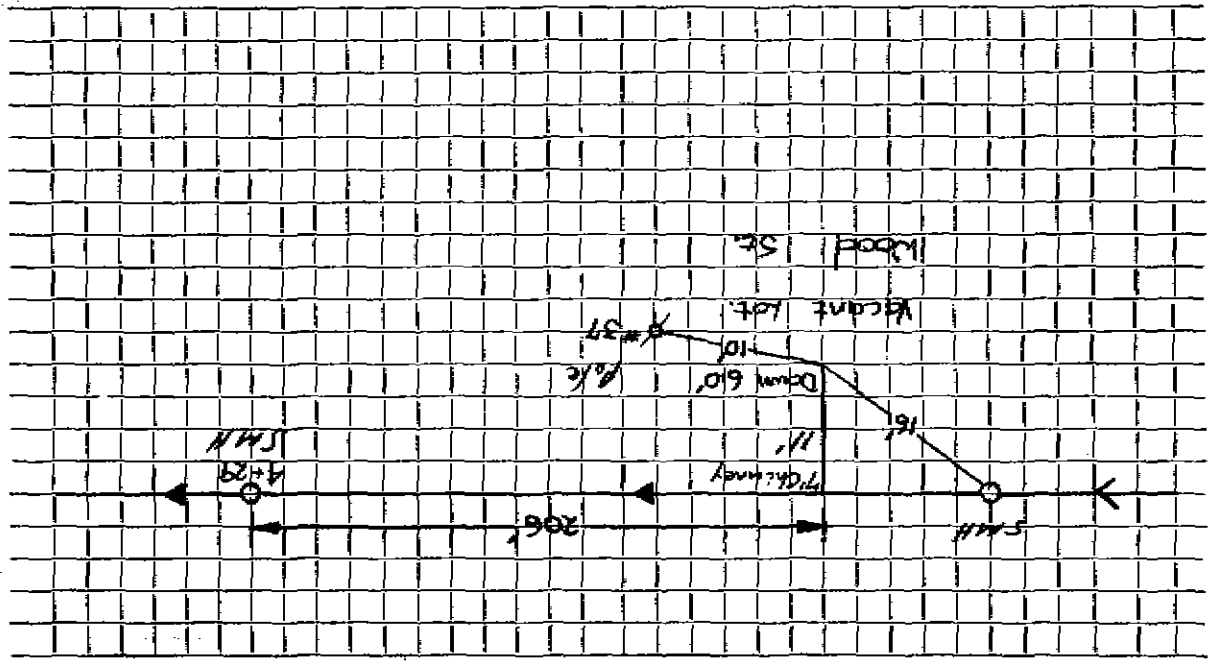

Street, Work completed


Connection made in **Wood**
 Remarks: **M.T.P. Property**

TOWN OF LEXINGTON — BOARD OF PUBLIC WORKS

SEWER DIVISION

DATE _____

Sketch of Service Here

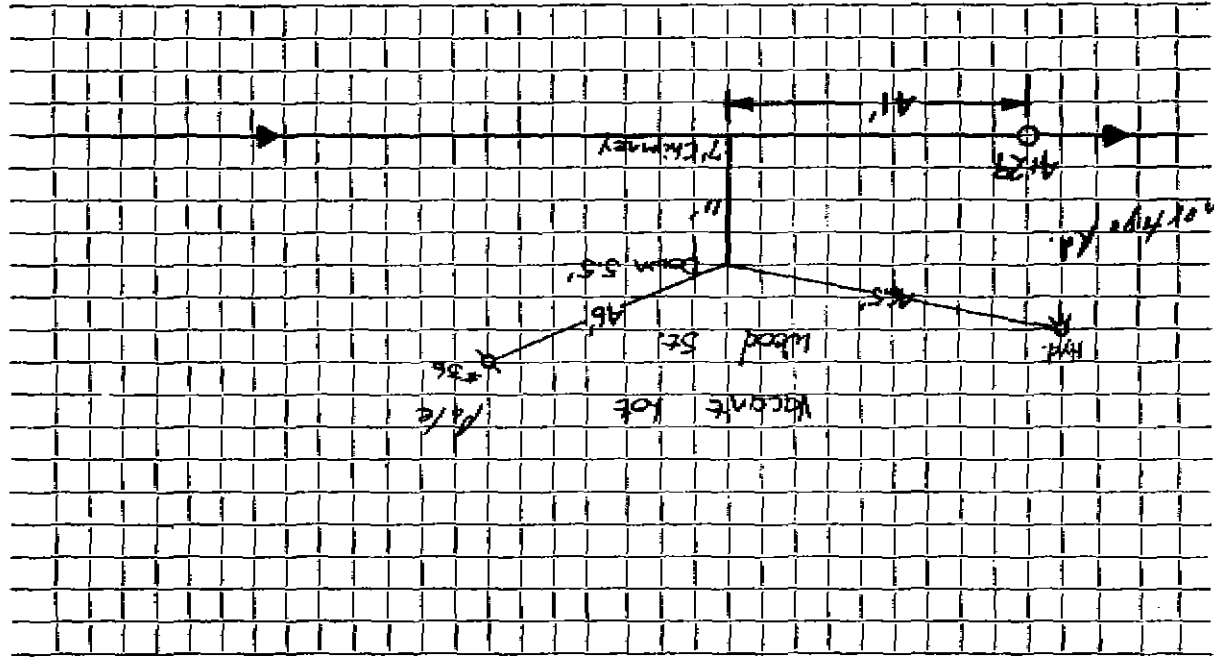

Street. Work completed

Connection made in Wood

Remarks: M. I. T. 10-2-79

To Coner Pipe