


TOWN OF LEXINGTON — BOARD OF PUBLIC WORKS

SEWER DIVISION

DATE _____

Sketch of Service Here

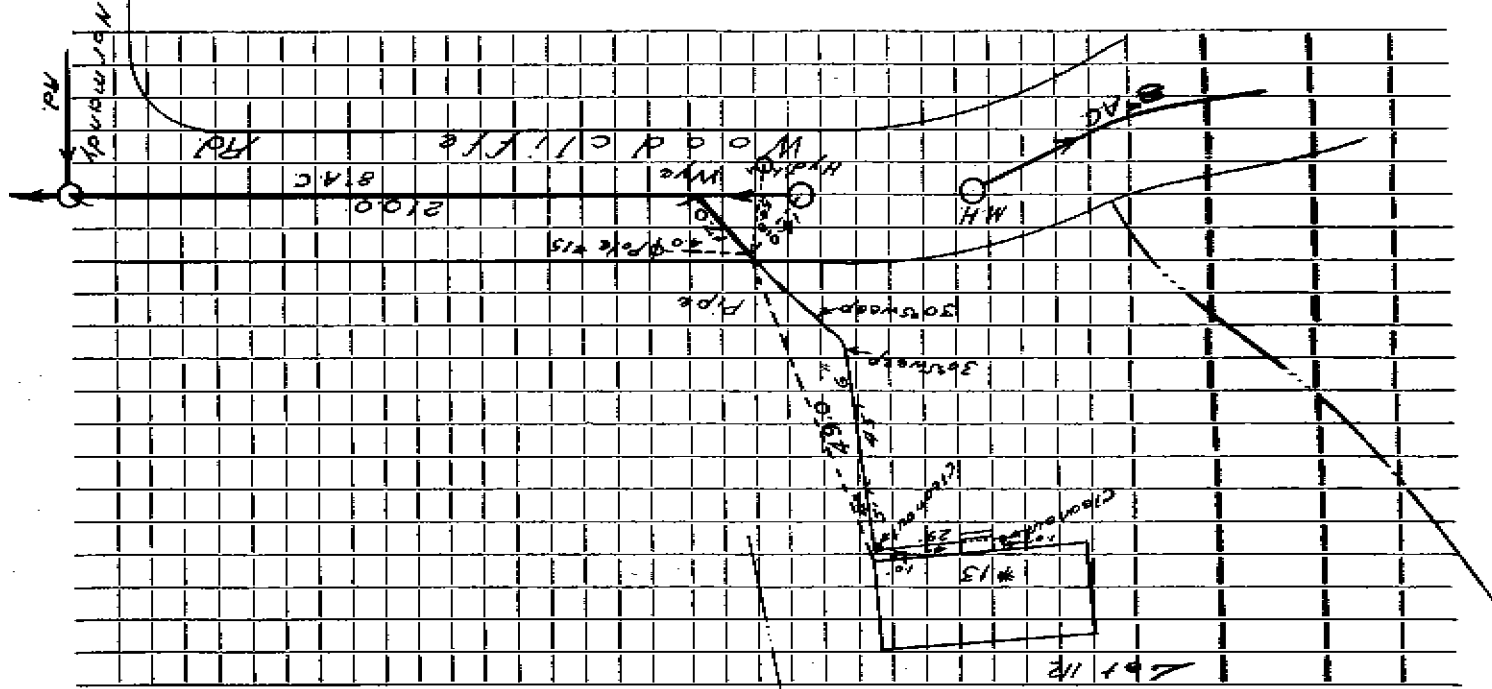

Connection made in _____ Street. _____ Work completed _____

Remarks: _____